


STATE OF KANSAS
STATE CORPORATION COMMISSION

Form CP-4

WELL PLUGGING RECORD

Give All Information Completely
Make Required Affidavit
Mail or Deliver Report to:
Conservation Division
State Corporation Commission
212 No. Market
Wichita, Kansas

NORTH

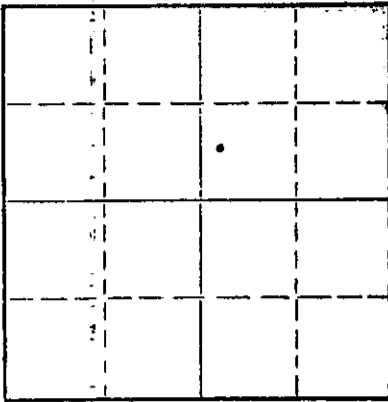

Locate well correctly on above
Section Plat

Ness County. Sec. 24 Twp. 18 Rge. (E) 21 (W)
Location as "NE/CNW&SW" or footage from lines. C W/2 SW/4 NE/4
Lease Owner Four-Way Operating, Inc.
Lease Name Pabst "C" Well No. 1
Office Address Box 698, Great Bend, Kansas
Character of Well (completed as Oil, Gas or Dry Hole) oil
Date well completed 19
Application for plugging filed May 29 19 67
Application for plugging approved 19
Plugging commenced June 5 19 67
Plugging completed June 8 19 67
Reason for abandonment of well or producing formation depleted

If a producing well is abandoned, date of last production 19
Was permission obtained from the Conservation Division or its agents before plugging was commenced? yes

Name of Conservation Agent who supervised plugging of this well Leo F. Massey
Producing formation Depth to top Bottom Total Depth of Well 4150 Feet
Show depth and thickness of all water, oil and gas formations.

OIL, GAS OR WATER RECORDS

CASING RECORD

FORMATION	CONTENT	FROM	TO	SIZE	PUT IN	PULLED OUT
		0	103'	13"	103'	none
		0	1300'	8 5/8"	1300'	none
		0	4149'	5 1/2"	4149'	2925.40

Describe in detail the manner in which the well was plugged, indicating where the mud fluid was placed and the method or methods used in introducing it into the hole. If cement or other plugs were used, state the character of same and depth placed, from feet to feet for each plug set.

Pushed plug to 4000', set 10' rock bridge and dumped 5 sacks of cement at 3990'.
Bailed hole down to 375', set 25' wood and rock bridge and filled hole with 5 yards of redi-mix concrete.

RECEIVED
STATE CORPORATION COMMISSION
JUN 21 1967
6-21-67
CONSERVATION DIVISION
Wichita, Kansas

(If additional description is necessary, use BACK of this sheet)
Name of Plugging Contractor Pipe Pullers, Inc.
Address Box 486, Ellinwood, Kansas

STATE OF Kansas, COUNTY OF Barton, ss.
Dean Wells (employee of owner) or (owner or operator) of the above-described well, being first duly sworn on oath, says: That I have knowledge of the facts, statements, and matters herein contained and the log of the above-described well as filed and that the same are true and correct. So help me God.

(Signature) *Dean Wells*
Ellinwood, Kansas

SUBSCRIBED AND SWORN TO before me this 12th day of June, 19 67

My commission expires July 7, 1968

Notary Public. *J. Rader*

DRILLERS' LOG

Well Owner: Continental Oil Company
 Farm Name: Fred Pabst #1
 Commenced: 7/29/58
 Completed: 8/12/58
 Total Depth: 4150'
 Casing: 13 3/8" @ 103' cemented
 8 5/8" @ 1300' cemented
 5 1/2" @ 4149' cemented

2060' from NL, 2310' from EL
 Sec. 24-18S-21W
 Ness County, Kansas

Elevation:

Production:

Contractor: Peel Brothers, Inc.

Figures below indicate bottoms of formations:

Surface soils	0 -	105
Shale & shells		665
Shale		730
Sand		965
Shale and shells		1025
Shale and sand		1300
Anhydrite		1335
Shale and shells		1620
Shale		2215
Shale and lime		3390
Lime		3435
Lime and shale		3590
Lime		4038
Core		4086
Shale and lime		4115
Lime		4150
Total Depth		4150

RECEIVED
 STATE CORPORATION COMMISSION

JUN 12 1967

CONSERVATION DIVISION
 Topeka, Kansas

This is to certify that the above information is to the best of our knowledge, true and correct.

PEEL BROTHERS, INC.

BY Jack Matthews

SUBSCRIBED AND SWORN to before me this 13th day of August, 1958

My commission expires: April 27, 1960

Ruth Brant
 Notary Public