

15.135.00506 0000


STATE OF KANSAS
STATE CORPORATION COMMISSION

Be All Information Completely
Make Required Affidavit
Mail or Deliver Report to:
Conservation Division
State Corporation Commission
211 No. Broadway
Wichita, Kansas

WELL PLUGGING RECORD

Ness County. Sec. 24 Twp. 18S Rge. (E) 21 (W)
Location as "NE/CNW&SW&" or footage from lines SW NW NE
Lease Owner Continental Oil Company
Lease Name L. C. Young Well No. 1
Office Address Box 161, Great Bend, Kansas
Character of Well (completed as Oil, Gas or Dry Hole) Dry Hole
Date well completed 7-25 19 59
Application for plugging filed 7-27 19 59
Application for plugging approved 7-25 19 59
Plugging commenced 7-25 19 59
Plugging completed 7-25 19 59
Reason for abandonment of well or producing formation No commercial zones encountered.
If a producing well is abandoned, date of last production 19
Was permission obtained from the Conservation Division or its agents before plugging was commenced? yes

NORTH

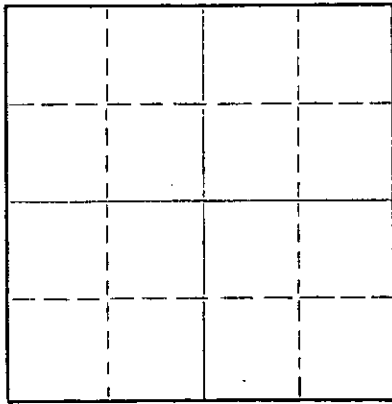

Locate well correctly on above
Section Plat

Name of Conservation Agent who supervised plugging of this well Mr. Gilbert Leiker
Producing formation None Depth to top Bottom Total Depth of Well 4153 Feet
Show depth and thickness of all water, oil and gas formations.

OIL, GAS OR WATER RECORDS

CASING RECORD

FORMATION	CONTENT	FROM	TO	SIZE	PUT IN	PULLED OUT
<u>None</u>				<u>13 3/8"</u>	<u>89'</u>	<u>None</u>
				<u>8 5/8"</u>	<u>1349'</u>	<u>None</u>

Describe in detail the manner in which the well was plugged, indicating where the mud fluid was placed and the method or methods used in introducing it into the hole. If cement or other plugs were used, state the character of same and depth placed, from feet to feet for each plug set.

Pumped mud in hole and spotted 20 sacks of cement at 600'. Spotted 15 sacks of cement at 200'. Spotted 10 sacks of cement at 20' and 5 sacks in cellar bringing cement to top of hole.

RECEIVED
STATE CORPORATION COMMISSION

JUL 28 1959

CONSERVATION DIVISION
Wichita, Kansas

(If additional description is necessary, use BACK of this sheet)

Name of Plugging Contractor Capitt Drilling, Inc.
Address Wichita, Kansas

STATE OF Kansas, COUNTY OF Barton, ss.
F. L. Dunn (employee of owner) or (owner/operator) of the above-described well, being first duly sworn on oath, says: That I have knowledge of the facts, statements, and matters herein contained and the log of the above-described well as filed and that the same are true and correct. So help me God.

ARC
7-27-59
State DWM File

(Signature) F. L. Dunn
District Superintendent
Box 161, Great Bend, Kansas
(Address)

SUBSCRIBED AND SWORN TO before me this 27th day of July, 19 59

My commission expires 8-1-60

Jack D. M...
Notary Public.

PLUGGING
FILE SEC. 24 T. 18 R. S1W
BOOK PAGE 53 LINE 42

15-135-00586-0000

ROTARY DRILLING LOG

OPERATOR: Continental Oil Company
L. C. Young No. 1
990' FN and 2310' FEL
of Section 24-18S-21W,
Ness County, Kansas

CONTRACTOR: Capitt Drilling, Inc.
COMM: 7-10-59
COMP: 7-25-59

Remarks: Set 13-3/8" casing at 89'
cemented with 125 sacks
common cement.

Set 8-5/8" casing at 1349
cemented with 600 sacks
common, 4% Gel.

Formations:

Surface Hole	90'
Shale & Shells	390'
Shale & Sand	590'
Shale	790'
Sand	980'
Shale	1130'
Shale & Shells	1327'
Anhydrite	1353'
Anhydrite & Shale	1365'
Shale & Lime	2106'
Lime w/Shale Streaks	2255'
Shale & Lime Streaks	2340'
Lime & Shale Streaks	2440'
Lime	2730'
Lime & Shale	2830'
Shale & Lime	3010'
Shale & Lime Streaks	3150'
Lime & Shale	3600'
Lime	4122'
Lime & Chert	4146'
Lime	4153'

Rotary Total Depth (D&A) 4153'

RECEIVED
STATE GEOLOGICAL SURVEY
AUG 3 1959
CONSERVATION DIVISION
TOPEKA, KANSAS

We certify the above log is true and
correct to the best of our knowledge
and belief.

CAPITT DRILLING, INC.

R. R. McNicol /s/

R. R. McNicol

Kansas Geological Society
DWM
PJJ
File

PLUGGING
FILE SEC. 24 T. 18 R. 21W
BOOK PAGE 53 LINE 42