


STATE OF KANSAS
STATE CORPORATION COMMISSION

Give All Information Completely
Make Required Affidavit
Mail or Deliver Report to:
Conservation Division
State Corporation Commission
211 No. Broadway
Wichita, Kansas

WELL PLUGGING RECORD

NORTH

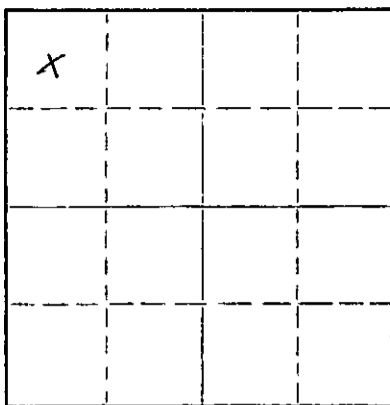

Locate well correctly on above
Section Plat

Barber County. Sec. 23 Twp. 32 Rge. 11 (E) W (W)
Location as "NE/CNW&SW&" or footage from lines C NENE
Lease Owner Mull Drilling Co., Inc.
Lease Name Elsea Well No. B1
Office Address 670 N. 14th. Natl. Bank Bldg. Wichita, Kansas
Character of Well (completed as Oil, Gas or Dry Hole) Dry hole
Date well completed 11-5-62 19
Application for plugging filed 11-5-62 19
Application for plugging approved 11-5-62 19
Plugging commenced 6:00 P.M. 11-5-62 19
Plugging completed 7:30 P.M. 11-5-62 19
Reason for abandonment of well or producing formation No Production.

If a producing well is abandoned, date of last production None 19
Was permission obtained from the Conservation Division or its agents before plugging was commenced? Yes

Name of Conservation Agent who supervised plugging of this well Herman Justus

Producing formation _____ Depth to top _____ Bottom _____ Total Depth of Well _____ Feet

Show depth and thickness of all water, oil and gas formations.

OIL, GAS OR WATER RECORDS

CASING RECORD

FORMATION	CONTENT	FROM	TO	SIZE	PUT IN	PULLED OUT

Describe in detail the manner in which the well was plugged, indicating where the mud fluid was placed and the method or methods used in introducing it into the hole. If cement or other plugs were used, state the character of same and depth placed, from _____ feet to _____ feet for each plug set.

Hole filled with drilling fluid to within 180' of surface. A plug put at this depth with $\frac{1}{4}$ sack hulls on plug and 20 sacks cement. Hole then filled to within 40' of surface and a plug put at this depth with $\frac{1}{4}$ sack hulls and 10 sacks cement. Two sacks cement was dumped in rat hole plugging same.

RECEIVED
STATE CORPORATION COMMISSION
NOV 12 1962
11-19-62
CONSERVATION DIVISION
Wichita, Kansas

(If additional description is necessary, use BACK of this sheet)

Name of Plugging Contractor Co. tools.

Address Same as above.

STATE OF KANSAS, COUNTY OF SEDGWICK, ss.
R. James Gear (employee of owner) or (owner or operator) of the above-described

well, being first duly sworn on oath, says: That I have knowledge of the facts, statements, and matters herein contained and the log of the above-described well as filed and that the same are true and correct. So help me God.

(Signature)

Wichita, Kansas

(Address)

SUBSCRIBED AND SWORN TO before me this 12th day of November, 1962

My commission expires October 16, 1965

Notary Public.

ROTARY DRILLERS LOG

COMPANY: Mull Drilling Co., Et al ROTARY DRILLING COMMENCED: 10-22-62
Wichita, Kansas

CONTRACTOR: Mull Drilling Co., Inc. ROTARY DRILLING COMPLETED: 11-5-62
Wichita, Kansas

CASING RECORD: Set 918' of 8 5/8" casing with 400 ex. cement.

LOCATION: #1 Elsea "B"
C NE NE 23-32S-14W
Barber County, Kansas

(Figures indicate bottom of formation - measurements from top of Rotary Bushing)

1020'	Red Bed
4065'	Lime & Shale
4126'	Lime
4252'	Lime & Shale
4293'	Lime
4403'	Lime & Shale
4430'	Cherty Lime
4466'	Cherty Lime w/Shale
4499'	Cherty Lime
4549'	Miss. Lime
4750'	Shale & Lime
4762'	Viola & Total Depth

RECEIVED
STATE CORPORATION COMMISSION

NOV 19 1962
11-19-62
CONSERVATION DIVISION
Wichita, Kansas

I hereby certify that this is a true and correct copy of the above log to the best of my knowledge.

MULL DRILLING COMPANY, INC.

Joseph B. Brungerdt, Jr.

STATE OF KANSAS)

COUNTY OF SEDGWICK)

Subscribed and sworn to before me this 16th day of November, 1962.

Lola L. Foster, Notary Public

My commission expires
April 17, 1966.

