


WELL PLUGGING RECORD

Give All Information Completely
Make Required Affidavit
Mail or Deliver Report to:
Conservation Division
State Corporation Commission
211 N. Broadway
Wichita, Kansas

Ness County, Sec. 35 Twp. 18 Rge. 21 (E) W (W)

Location as "NE/CNW/SW" or footage from lines NW SE SW
Lease Owner Stickle Drilling Co.
Lease Name Dank #1 Well No. 2
Office Address Wichita, Kansas
Character of Well (completed as Oil, Gas or Dry Hole) Dry Hole
Date well completed 10/20/57 19__
Application for plugging filed 19__
Application for plugging approved 19__
Plugging commenced 11-2-57 19__
Plugging completed 11-12-57 19__
Reason for abandonment of well or producing formation Dry Hole

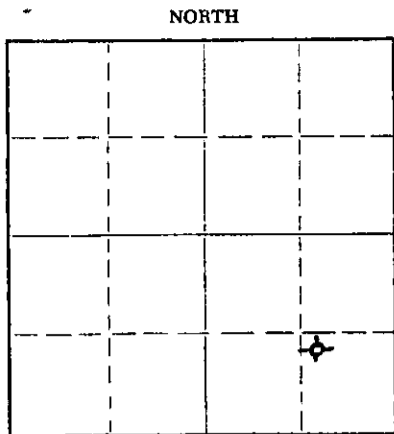

Locate well correctly on above Section Plat

If a producing well is abandoned, date of last production None 19__
Was permission obtained from the Conservation Division or its agents before plugging was commenced? yes

Name of Conservation Agent who supervised plugging of this well Donald Truan
Producing formation None Depth to top _____ Bottom _____ Total Depth of Well 4224 Feet
Show depth and thickness of all water, oil and gas formations.

OIL, GAS OR WATER RECORDS

CASING RECORD

FORMATION	CONTENT	FROM	TO	SIZE	PUT IN	PULLED OUT
				8-5/8"	366'	none
				5-3/4"	4219'	3883'

Describe in detail the manner in which the well was plugged, indicating where the mud fluid was placed and the method or methods used in introducing it into the hole. If cement or other plugs were used, state the character of same and depth placed, from _____ feet to _____ feet for each plug set.

Checked the hole to 4224' and found it open. Filled w/sand to 4210' and ran 5 sacks of cement. Pulled 5 3/4" casing. Bailed oil to 40'. Mudded the hole and bailed the hole to 350', set a 10' rock bridge to 340' and ran 25 sacks of cement. Mudded the hole to 40', set a 10' rock bridge to 30' and ran 10 sacks of cement to base of cellar.

RECEIVED
STATE CORPORATION COMMISSION
11-15-57
NOV 15 1957
CONSERVATION DIVISION
Wichita, Kansas

(If additional description is necessary, use BACK of this sheet)
Name of Plugging Contractor West Supply Co., Inc.
Address Chase, Kansas

STATE OF KANSAS COUNTY OF RICE, ss.
R. B. Parriott (Employee or owner or (owner or operator) of the above-described well, being first duly sworn on oath, says: That I have knowledge of the facts, statements, and matters herein contained and the log of the above-described well as filed and that the same are true and correct. So help me God.

(Signature) R. B. Parriott
1027 Union Center, Wichita 2, Ks.
(Address)

SUBSCRIBED AND SWORN TO before me this 13th day of November, 19 57

Thomas V. Saggin
Notary Public.

My commission expires 9-27-58

PLUGGING
FILE SEC 35 T 18 R 21 W
BOOK PAGE 56 LINE 16

Stickle Drilling Company, Production
Wichita, Kansas

15735-00565000
Tulsa, Oklahoma
October 14, 1957

CONTRACTOR: Stickle Drilling Company
Drilling Commenced: September 25, 1957
Drilling Completed: October 9, 1957

Lank #2 NW SE SW Section
35-18S-21W, Ness County,
Kansas

DRILLERS LOG

Total Depth Figure Indicate base of formation;

Shale & Shells	850
Red Bed & Shale	1335
Shale & Shells	1370
Anhydrite	1405
Red Bed, Shale & Shells	1545
Shale & Shells	1840
Shale	2115
Shale & Shells	2190
Lime & Shale	2420
Lime	2545
Lime & Shale	2660
Shale & Lime	2910
Lime & Shale	3145
Shale & Lime	3250
Lime & Shale	3445
Lime	3535
Shale & Lime	3660
Lansing Lime	3670
Lime	4096
Lime & Shale	4192
Shale & Lime	4205
Conglomerate	4220
Lime & Sand	4224 TD

I, Frank E. Stickle hereby certify the above to be a true and complete Drillers Log of Stickle Drilling Etal, Lank #2 NW SE SW Section 35-18S-21W, Ness County, Kansas.

Frank E. Stickle
Frank E. Stickle

Lillian T. Bonham
Notary Public

February 13, 1960
My Commission Expires

OCT 21 1957
CONSERVATION
Wichita, Kansas

PLUGGING			
FILE	SEC	35 T 18	R 21W
BOOK	PAGE	56	LINE 16