

15-115-20174-0000

STATE OF KANSAS
STATE CORPORATION COMMISSION

Form CP-4

Give All Information Completely
Make Required Affidavit
Mail or Deliver Report to:
Conservation Division
State Corporation Commission
212 No. Market
Wichita, Kansas 67202

WELL PLUGGING RECORD

Marion County, Sec. 20 Twp. 17 Rge. 4 (E) (W)

Location as "NE/CNW/SW" or footage from lines. C - NE - NW

Lease Owner Slusser Drilling Co.

Lease Name Shields Well No. 2

Office Address Box 275 Marion, Kansas 66861

Character of Well (completed as Oil, Gas or Dry Hole)

Date well completed 3 - 20 19 72

Application for plugging filed 7 - 19 19 74

Application for plugging approved 7 - 19 19 74


Plugging commenced 8 - 8 19 74

Plugging completed 8 - 11 19 74

Reason for abandonment of well or producing formation Production exhausted

If a producing well is abandoned, date of last production 1 - 15 19 74

Was permission obtained from the Conservation Division or its agents before plugging was commenced? yes

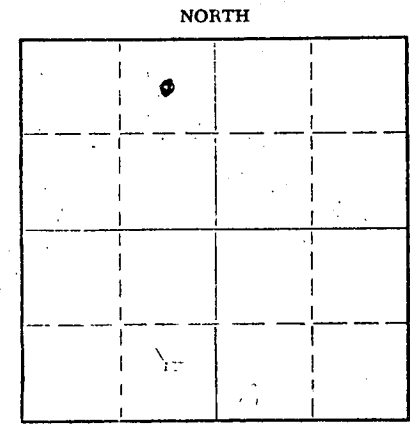

Locate well correctly on above Section Plat

Name of Conservation Agent who supervised plugging of this well Hough Scott

Producing formation Mississippi Chat Depth to top 2370 Bottom 2425 Total Depth of Well 2425 Feet

Show depth and thickness of all water, oil and gas formations.

OIL, GAS OR WATER RECORDS

CASING RECORD

FORMATION	CONTENT	FROM	TO	SIZE	PUT IN	PULLED OUT
				8 5/8	152	none
				5 1/2	2373	2050

Describe in detail the manner in which the well was plugged, indicating where the mud fluid was placed and the method or methods used in introducing it into the hole. If cement or other plugs were used, state the character of same and depth placed, from _____ feet to _____ feet for each plug set.

Filled hole with sand to 2350 ft.
Dumped 5 sax cement on sand. Pulled pipe.
Mudded hole to 180 ft. Set 10 ft. rock bridge on mud.
Dumped 25 sax cement on bridge. Filled with mud to 40 ft.
Set 10 ft. rock bridge on mud. Filled to surface with cement. Plugging completed.

RECEIVED
STATE CORPORATION COMMISSION
AUG 15 1974

CONSERVATION DIVISION
Wichita, Kansas

(If additional description is necessary, use BACK of this sheet)

Name of Plugging Contractor Slusser Drilling Co.


Address Box 275 Marion, Kansas 66861

STATE OF Kansas, COUNTY OF Marion, ss.

Billy H. Slusser (employee of owner) or (owner or operator) of the above-described well, being first duly sworn on oath, says: That I have knowledge of the facts, statements, and matters herein contained and the log of the above-described well as filed and that the same are true and correct. So help me God.

(Signature) Billy H. Slusser
Marion, Kansas 66861 (Address)

Subscribed and sworn to before me this 14th day of August, 1974

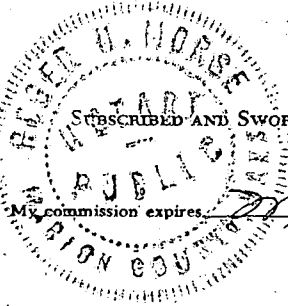

Roger H. Morse Notary Public.

DRILLERS LOG

Company	Slusser Drilling Company	Commenced 4/3/72
Contractor	Slusser Drilling Company	Completed 4/6/72
Farm	Shields #2	C NE NW 20-17-4
8/5/8	@ 152	Marion County, Kansas
5' 1/2	@ 2373	

Surface soil	5
Shale & shells	45
Lime, shale & shells	450
Shale and lime	485
Shale and shells	1300
Shale and lime	1480
Lime and shale	1635
Lime, shale & sand	1812
Lime	2190
Lime and shale	2335
Shale and shells	2362
Red rock & chat	2370
Chat	2425 Rotary T.D.

RECEIVED
STATE CORPORATION COMMISSION

JUL 19 1974

CONSERVATION DIVISION
Wichita, Kansas