

Change of operator
AFFIDAVIT OF COMPLETION FORM

ACO-1 WELL HISTORY

TYPE

SIDE ONE

Two (2) copies of this form shall be filed with the Kansas Corporation Commission, 200 Colorado Derby Building, Wichita, Kansas 67202, within thirty (30) days after the completion of a well, regardless of how the well was completed.


Attach separate letter of request if the information is to be held confidential. If confidential, only file one copy. Information on Side One will be of public record and Side Two will then be held confidential.

Applications must be made on dual completion, commingling, salt water disposal, injection and temporarily abandoned wells.

Attach one copy only wireline logs (i.e. electrical log, sonic log, gamma ray neutron log, etc.). (Rules 82-2-105 & 82-2-125) KCC# (316) 263-3238.

LICENSE # 5267 5266 EXPIRATION DATE 6/30/83
 OPERATOR K & E Drilling Petroleum, Inc. (ON behalf of K & E Petroleum, Inc.) API NO. 15-135-22,281-0006
 ADDRESS 100 South Main, Suite 300 Hardage Center COUNTY Ness
Wichita, Kansas 67202 FIELD Bazine
 ** CONTACT PERSON Wayne L. Brinegar PROD. FORMATION Mississippian
 PHONE 316-264-4301
 PURCHASER Clear Creek, Inc. LEASE Schniepp
 ADDRESS P. O. Box 1045 WELL NO. 1
McPherson, Kansas 67460 WELL LOCATION C W/2 W/2 NW
 DRILLING CONTRACTOR Abercrombie Drilling, Inc. 1320 Ft. from North Line and
 ADDRESS 801 Union Center 340 Ft. from West Line of
Wichita, Kansas 67202 the NW (Qtr.) SEC 33 TWP 18S RGE 21W.

PLUGGING CONTRACTOR ADDRESS

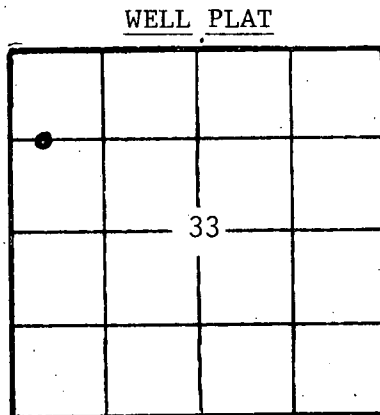

(Office Use Only)

KCC
 KGS
 SWD/REP _____
 PLG. _____

TOTAL DEPTH 4219' PBTD _____
 SPUD DATE 9/1/82 DATE COMPLETED 9/28/82
 ELEV: GR 2115' DF _____ KB 2120'

DRILLED WITH ~~WABRIX~~ (ROTARY) ~~WABRIX~~ TOOLS.
 DOCKET NO. OF DISPOSAL OR REPRESSURING WELL BEING USED TO DISPOSE OF WATER FROM THIS LEASE CD-4,774

Amount of surface pipe set and cemented 363.10 DV Tool Used? Yes

THIS AFFIDAVIT APPLIES TO: (Circle ONE) - Oil, Gas, Shut-in Gas, Dry, Disposal, Injection, Temporarily Abandoned, OWWO. Other _____

ALL REQUIREMENTS OF THE STATUTES, RULES AND REGULATIONS PROMULGATED TO REGULATE THE OIL AND GAS INDUSTRY HAVE BEEN FULLY COMPLIED WITH.


A F F I D A V I T

Wayne L. Brinegar, being of lawful age, hereby certifies that:

I am the Affiant, and I am familiar with the contents of the foregoing Affidavit. The statements and allegations contained therein are true and correct.

Wayne L. Brinegar
 (Name) Wayne L. Brinegar

SUBSCRIBED AND SWORN TO BEFORE ME this 5th day of October,

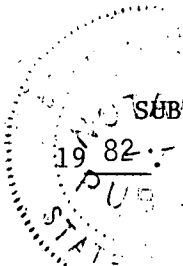

MY COMMISSION EXPIRES: September 6, 1983

Betty J. Weltz
 (Name) Betty Weltz

STATE CORPORATION COMMISSION
 RECEIVED PUBLIC

OCT 06 1982
 CONSERVATION DIVISION
 Wichita, Kansas

** The person who can be reached by phone regarding any questions concerning this information.

10-6-82

