

STATE OF KANSAS
STATE CORPORATION COMMISSION


WELL PLUGGING RECORD

Give All Information Completely
Make Required Affidavit
Mail or Deliver Report to:
Conservation Division
State Corporation Commission
800 Bitting Building
Wichita, Kansas

Barber County, Sec. 13 Twp. 32 Rge. 13 (X) W (W)

Location as "NE/CNW&SW" or footage from lines SE SE SE
Lease Owner PETROLEUM, INC.
Lease Name Lonker Well No. 1
Office Address Route 2 Great Bend, Kansas
Character of Well (completed as Oil, Gas or Dry Hole) Dry Hole
Date well completed September 14, 1956
Application for plugging filed September 17, 1956
Application for plugging approved September 14, 1956
Plugging commenced September 14, 1956
Plugging completed September 14, 1956
Reason for abandonment of well or producing formation No Producible Zones

NORTH

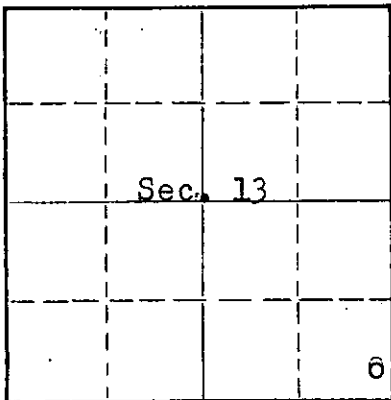

Locate well correctly on above
Section Plat

If a producing well is abandoned, date of last production None 19
Was permission obtained from the Conservation Division or its agents before plugging was commenced? Yes

Name of Conservation Agent who supervised plugging of this well M. A. Rives Box 8, Pratt, Kansas
Producing formation ----- Depth to top -- Bottom ----- Total Depth of Well 4,532 Feet
Show depth and thickness of all water, oil and gas formations.

OIL, GAS OR WATER RECORDS

CASING RECORD

FORMATION	CONTENT	FROM	TO	SIZE	PUT IN	PULLED OUT
				8 5/8" OD	290'	None

Describe in detail the manner in which the well was plugged, indicating where the mud fluid was placed and the method or methods used in introducing it into the hole. If cement or other plugs were used, state the character of same and depth placed, from _____ feet to _____ feet for each plug set.

Mud up with heavy mud to 285' pushed down 1/4 sack hulls to 285' followed by wooden plug. Placed 20 sacks cement through drill pipe on to plug. Mud up to 35' and placed 1/4 sack hulls at 35' followed by wooden plug and 10 sacks cement to base of well cellar.

RECEIVED
STATE CORPORATION COMMISSION
WICHITA, KANSAS
SEP 22 1956
09-22-56

(If additional description is necessary, use BACK of this sheet)

Name of Plugging Contractor Garvey Drilling Co.
Address Route 2 Great Bend, Kansas

STATE OF KANSAS, COUNTY OF BARTON, ss.
DON SEARLE (employee of owner) or (owner or operator) of the above-described well, being first duly sworn on oath, says: That I have knowledge of the facts, statements, and matters herein contained and the log of the above-described well as filed and that the same are true and correct. So help me God.

(Signature) Don Searle
Route 2 Great Bend, Kansas (Address)

SUBSCRIBED AND SWORN TO before me this 20th day of September, 1956

Led A. Brown
Notary Public.

My commission expires July 11, 1960

PLUGGING
FILE SEC 13 T 32 R 13W
BOOK PAGE 99 LINE 26

WELL LOG

COMPANY **Petroleum Inc.**

SEC. **13 T. 32 S. R. 13 W**

FARM **Lonker**

NO. **1**

LOC. **SE-SE-SE**


TOTAL DEPTH **4532**

COUNTY **Barber**

COMM. **8-28-56**

COMP. **9-14-56**

CONTRACTOR **Garvey Drilling Co.**

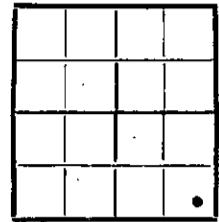

CASING **290' - 8 5/8"**

ELEVATION **1598' DF**

PRODUCTION **D & A**

FIGURES INDICATE BOTTOM OF FORMATIONS

Miss. - 4384'

- 50' - Sand & Shale
- 260' - Red Bed
- 500' - Red Bed & Blue shale
- 1525' - Shale & Shells
- 2020' - Lime & Shale
- 2125' - Lime
- 3319' - Lime & Shale
- 3586' - Lime
- 3942' - Lime & Shale
- 4331' - Lime
- 4369' - Lime & Shale
- 4408' - Lime
- 4423' - Chat
- 4450' - Chert
- 4532' - Lime

RECEIVED
STATE COMMISSION
SEP 22 1956
CONSERVATION DIVISION
Wichita, Kansas

PLUGGING
FILE SEC. 13 T. 32 R. 13 W
BOOK PAGE 99 LINE 26

State of Kansas }
County of Barton } ss:

I, Fred Bennett of Garvey Drilling Co.

upon oath state that the above and foregoing is a true and correct copy of the log of the #1 Lonker well

Fred Bennett

Subscribed and sworn to before me this 20th day of September 19 56

My Commission Expires: July 11, 1960

Fred J. Brown
NOTARY PUBLIC