


STATE OF KANSAS
STATE CORPORATION COMMISSION

WELL PLUGGING RECORD

Give All Information Completely
Make Required Affidavit
Mail or Deliver Report to:
Conservation Division
State Corporation Commission
800 Bittling Building
Wichita, Kansas

Barber County. Sec. 15 Twp. 32 Rge. 13 (E) W (W)
Location as "NE/CNW/SW" or footage from lines C S/2 N/2 NE NE
Lease Owner PETROLEUM, INC.
Lease Name SMITH "W" Well No. 1
Office Address Route 2, Great Bend, Kansas
Character of Well (completed as Oil, Gas or Dry Hole) Dry hole
Date well completed November 1 19 56
Application for plugging filed November 1 19 56
Application for plugging approved November 1 19 56
Plugging commenced November 1 19 56
Plugging completed November 1 19 56
Reason for abandonment of well or producing formation No producible zones

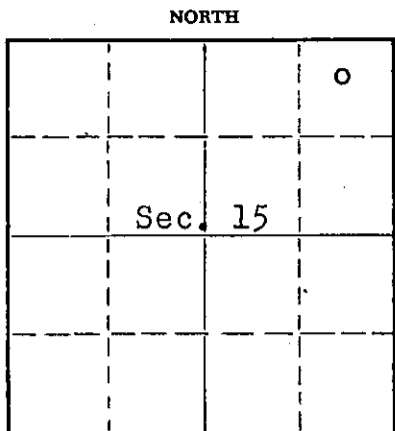

Locate well correctly on above
Section Plat

If a producing well is abandoned, date of last production None 19
Was permission obtained from the Conservation Division or its agents before plugging was commenced? Yes

Name of Conservation Agent who supervised plugging of this well M.A. Rives Pratt, Kansas
Producing formation --- Depth to top -- Bottom -- Total Depth of Well 4572 Feet
Show depth and thickness of all water, oil and gas formations.

OIL, GAS OR WATER RECORDS

CASING RECORD

FORMATION	CONTENT	FROM	TO	SIZE	PUT IN	PULLED OUT
				8 5/8"	254'	None

Describe in detail the manner in which the well was plugged, indicating where the mud fluid was placed and the method or methods used in introducing it into the hole. If cement or other plugs were used, state the character of same and depth placed, from feet to feet for each plug set.

Mud up to 240', pushed down 1/4 sack hulls to 240' followed by wooden plug. Placed 20 sacks cement through drill pipe on to plug. Mud up to 35' and place 1/4 sack hulls to 35' followed by wooden plug and 10 sacks cement to base of well cellar.

RECEIVED
STATE CORPORATION COMMISSION
11-10-56

(If additional description is necessary, use BACK of this sheet)
Name of Plugging Contractor Garvey Drilling Co.
Address Route 2, Great Bend, Kansas

STATE OF KANSAS, COUNTY OF BARTON, ss.
DON SEARLE (employee of owner) or (owner or operator) of the above-described well, being first duly sworn on oath, says: That I have knowledge of the facts, statements, and matters herein contained and the log of the above-described well as filed and that the same are true and correct. So help me God.

(Signature) Don Searle
Route 2, Great Bend, Kansas
(Address)

SUBSCRIBED AND SWORN TO before me this 9th day of November 19 56

Julius Brown
Notary Public.

My commission expires July 11, 1960

PLUGGING
FILE SEC. 15 T. 32 R. 13W
BOOK PAGE 112 LINE 40

WELL LOG

COMPANY PETROLEUM, INCORPORATED

SEC. 15 T. 32S R. 13W

FARM Smith 'W' NO. 1


LOC. C/S/2 N/2 NE, NE

TOTAL DEPTH 4572'

COUNTY Barber Co., Kansas

COMM. October 18, 1956 COMP. November 1, 1956

CONTRACTOR GARVEY DRILLING COMPANY

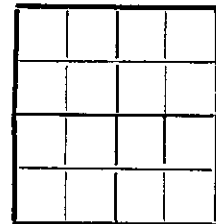

CASING 8 5/8" @ 254' W/165 sax.

ELEVATION 1749' DF

PRODUCTION D & A

FIGURES INDICATE BOTTOM OF FORMATIONS

195	Clay & shale	Heebner	3784'
256	Red bed	Douglas	3830'
810	Shale	Kansas City	3963'
1685	Shale & shells	Mississippi	4472'
2555	Lime & shale		
2705	Shale & shells		
2955	Shale & lime		
3100	Shale		
3575	Shale & lime		
3758	Shale		
3885	Shale & lime		
3976	Shale & sand		
4030	Lime & shale		
4148	Lime		
4207	Lime & shale		
4421	Lime		
4494	Lime & shale		
4525	Lime		
4572	Lime & shale		
4572	T. D.		

RECEIVED
STATE CORPORATION COMMISSION
NOV 10 1955
CONSERVATION DIVISION
Wichita, Kansas

PLUGGING
FILE SEC 15 T 32 R 13W
BOOK PAGE 112 LINE 40

State of KANSAS }
County of BARTON } SS:

I, Verne A. Morris of Garvey Drilling Co.

upon oath state that the above and foregoing is a true and correct copy of the log of the #1 Smith 'W' well

Verne A. Morris

Subscribed and sworn to before me this 8th day of November 19 56

My Commission Expires: July 11, 1960

Red J. Brown
NOTARY PUBLIC