

15-077-00218-0000


STATE OF KANSAS
STATE CORPORATION COMMISSION

WELL PLUGGING RECORD

Give All Information Completely
Make Required Affidavit
Mail or Deliver Report to:
Conservation Division
State Corporation Commission
211 No. Broadway
Wichita, Kansas

Harper County, Sec. 2 Twp. 32 Rge. 9 (E) (W)

Location as "NE/CNW/SW" or footage from lines NW/4 NW/4
Lease Owner Iron Drilling Company
Lease Name Dusenbury "B" Well No. 1
Office Address 1206 Philtower Bldg., Tulsa, Oklahoma
Character of Well (completed as Oil, Gas or Dry Hole) Dry Hole
Date well completed November 25 19 56
Application for plugging filed " 25 19 56
Application for plugging approved " 25 19 56
Plugging commenced " 25 19 56
Plugging completed " 25 19 56
Reason for abandonment of well or producing formation Dry Hole

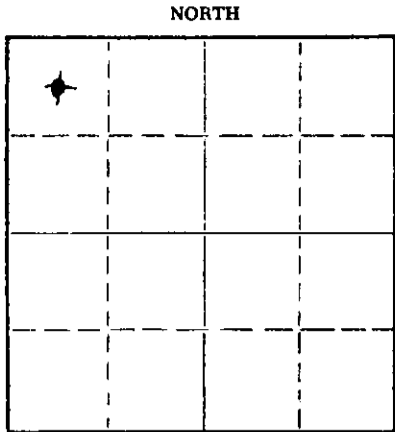

Locate well correctly on above
Section Plat

If a producing well is abandoned, date of last production None 19
Was permission obtained from the Conservation Division or its agents before plugging was commenced? Yes

Name of Conservation Agent who supervised plugging of this well M. A. Rives
Producing formation None Depth to top _____ Bottom _____ Total Depth of Well 4380 Feet
Show depth and thickness of all water, oil and gas formations.

OIL, GAS OR WATER RECORDS

CASING RECORD

FORMATION	CONTENT	FROM	TO	SIZE	PUT IN	PULLED OUT
Heebner		3382		8-5/8"	194	None
Toronto		3408				
Douglas		3452				
Lansing		3580				
Mississippi		4327				

Describe in detail the manner in which the well was plugged, indicating where the mud fluid was placed and the method or methods used in introducing it into the hole. If cement or other plugs were used, state the character of same and depth placed, from _____ feet to _____ feet for each plug set.

Hole filled with heavy mud to 180 feet.
Set wood plug and cemented w/20 sacks of cement and 1/4 sack of hulls.
Hole filled with heavy mud to 30 feet.
Set wood plug and cemented w/10 sacks of cement and 1/4 sack of hulls.

(If additional description is necessary, use BACK of this sheet)

Name of Plugging Contractor Iron Drilling Company
Address 1206 Philtower Bldg., Tulsa, Oklahoma

STATE OF Oklahoma, COUNTY OF Tulsa, ss.
J. L. Stackpole (employee of owner) or (owner or operator) of the above-described well, being first duly sworn on oath, says: That I have knowledge of the facts, statements, and matters herein contained and the log of the above-described well as filed and that the same are true and correct. So help me God.

(Signature) J. L. Stackpole
Tulsa, Oklahoma

SUBSCRIBED AND SWORN TO before me this 4th day of December 19 56

RECEIVED
STATE CORPORATION COMMISSION

B. Michal
Notary Public.

My commission expires February 28, 1960

PLUGGING
FILE SEC 2 T. 32 R. 9W
BOOK PAGE 119 LI E. 43

12-6-56

DRILLING RECORD

Well: Dusenbury "B" No. 1
 NW NW, Section 2-32S-9W
 Harper County, Kansas

194' 8-5/8" Surface Casing
 cemented w/135 sacks.

Work Commenced: 11-10-56
 Drilling Commenced: 11-10-56
 Drilling Completed: 11-25-56
 Work Completed: 11-26-56

WELL LOG

Surface soil	0	to	120
Red bed & shale	194	to	900
Shale & shells	900	to	1250
Shale & lime	1250	to	1375
Lime	1375	to	1590
Shale & lime	1590	to	3689
Lime	3689	to	3710
Lime & shale	3710	to	3784
Lime	3784	to	3898
Lime & shale	3898	to	3975
Lime	3975	to	4117
Lime & shale	4117	to	4176
Lime	4176	to	4243
Lime & shale	4243	to	4380 T.D.

RECEIVED
 STATE COMMISSION

DEC 6 - 1956
 12-6-56
 DIVISION
 WICHITA, KANSAS

PLUGGING
 SEC. 2 T. 32 R. 9W
 PAGE 119 LINE 43