


STATE OF KANSAS  
STATE CORPORATION COMMISSION

WELL PLUGGING RECORD

Give All Information Completely  
Make Required Affidavit  
Mail or Deliver Report to  
Conservation Division  
State Corporation Comm.  
245 North Water  
Wichita, KS 67202

Harper County, Sec. 2 Twp. 32S Rge. 9W E/W  
Location as "NE/CNW $\frac{1}{2}$ SW $\frac{1}{2}$ " or footage from lines  
NW NW NE

Lease Owner Howell Oil Co, Inc.  
Lease Name Dusenbury Well No. 1  
Office Address PO Box 2091, Hutchinson, Ks. 67501  
Character of Well (Completed as Oil, Gas or Dry Hole)  
Dry Hole

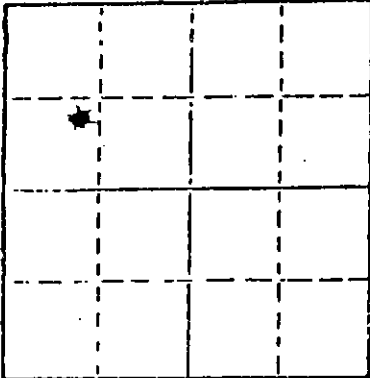

Locate well correctly on above  
Section Plot

Date Well completed 7-26 1981  
Application for plugging filed 7-26 1981  
Application for plugging approved 7-25 1981  
Plugging commenced 7-26 1981  
Plugging completed 7-26 1981  
Reason for abandonment of well or producing formation  
Dry

If a producing well is abandoned, date of last production  
19

Was permission obtained from the Conservation Division or  
its agents before plugging was commenced? Yes

Name of Conservation Agent who supervised plugging of this well Carl Barnett  
Producing formation \_\_\_\_\_ Depth to top \_\_\_\_\_ Bottom \_\_\_\_\_ Total Depth of Well 4392  
Show depth and thickness of all water, oil and gas formations.

OIL, GAS OR WATER RECORDS

CASING RECORD

FORMATION	CONTENT	FROM	TO	SIZE	PUT IN	PULLED OUT
		0	287	8 5/8		

Describe in detail the manner in which the well was plugged, indicating where the mud fluid  
was placed and the method or methods used in introducing it into the hold. If cement or other  
plugs were used, state the character of same and depth placed, from \_\_\_\_\_ feet to  
\_\_\_\_\_ feet for each plug set.

Plugged:  
35 sacks @ 300'  
10 sacks @ 40'  
5 sacks in rathole; 5 sacks in mousehole  
Completed by Halliburton  
2:30 PM 7-26-81

RECEIVED  
STATE CORPORATION COMMISSION  
8-12-81  
AUG 12 1981

(If additional description is necessary, use BACK of this sheet)

Name of Plugging Contractor DaMac Drilling Inc. CONSERVATION DIVISION  
Box 1164, Great Bend, Ks. 67530 Wichita, Kansas

STATE OF Kansas COUNTY OF Barton, ss.  
Martha J. McKown (employee of owner) or (owner or operator)  
of the above-described well, being first duly sworn on oath, says: That I have knowledge of  
the facts, statements, and matters herein contained and the log of the above-described well  
as filed and that the same are true and correct. So help me God.

(Signature) Martha J. McKown  
Box 1164, Great Bend, Ks. 67530  
(Address)

SUBSCRIBED AND SWORN TO before me this 27th day of July, 1981



Vada I. Sullivan  
Notary Public.

My commission expires \_\_\_\_\_