


15-077-00175-0000

STATE OF KANSAS
STATE CORPORATION COMMISSION

Give All Information Completely
Make Required Affidavit
Mail or Deliver Report to:
Conservation Division
State Corporation Commission
211 No. Broadway
Wichita, Kansas

WELL PLUGGING RECORD

NORTH

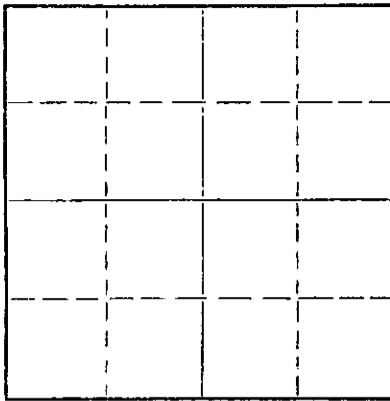

Locate well correctly on above
Section Plat

Harper County. Sec. 1 Twp. 32S Rge. 9W (E) (W)
Location as "NE/CNW/SW" or footage from lines. C SE SW
Lease Owner Rupp-Ferguson / Sierra Petroleum - Contr.
Lease Name PROUSE Well No. 1
Office Address 523 Petroleum Bldg., Wichita, Ks / 420 W Douglas, Wichita
Character of Well (completed as Oil, Gas or Dry Hole) dry
Date well completed 3/17/57 19
Application for plugging filed 3/16/57 19
Application for plugging approved 3/17/57 19
Plugging commenced 3/17/57 19
Plugging completed 3/17/57 19
Reason for abandonment of well or producing formation dry

If a producing well is abandoned, date of last production 19
Was permission obtained from the Conservation Division or its agents before plugging was commenced? yes

Name of Conservation Agent who supervised plugging of this well M. A. Rives
Producing formation _____ Depth to top _____ Bottom _____ Total Depth of Well 4480 Feet
Show depth and thickness of all water, oil and gas formations.

OIL, GAS OR WATER RECORDS

CASING RECORD

FORMATION	CONTENT	FROM	TO	SIZE	PUT IN	PULLED OUT
				8 5/8	218	none

Describe in detail the manner in which the well was plugged, indicating where the mud fluid was placed and the method or methods used in introducing it into the hole. If cement or other plugs were used, state the character of same and depth placed, from _____ feet to _____ feet for each plug set.

PLUGGING RECORD

Filled hole with heavy mud from 4480 up to 200'. Bridged with 1/3 sack hulls set wood plug and 20 sacks cement through drill pipe up to 160'. Filled with mud from 160' up to 35'. Set bridge with 1/3 sack hulls - Set wood plug - 10 sacks cement to cellar 0. Job complete 2 a.m. 3/17/57

(If additional description is necessary, use BACK of this sheet)

Name of Plugging Contractor Sierra Petroleum Co., Inc.
Address 420 W. Douglas Ave., Wichita, Kansas

STATE OF KANSAS, COUNTY OF RUSSELL, ss.
C. T. Honaker (employee of owner) or (owner or operator) of the above-described well, being first duly sworn on oath, says: That I have knowledge of the facts, statements, and matters herein contained and the log of the above-described well as filed and that the same are true and correct. So help me God.

(Signature) C. T. Honaker.
(Address)

SUBSCRIBED AND SWORN TO before me this 18th day of March, 19 57

My commission expires 1-30-61.

Margie Cooper
RECEIVED
STATE CORPORATION COMMISSION
MAR 19 1957
3-19-57
CONSERVATION DIVISION
Wichita, Kansas
Notary Public.

PLUGGING
FH. SEC. 1 T32 R9W
BOOK PAGE 149 LINE 2

Rupp-Ferguson - Owner

Sierra Petroleum Co - Contr.

PROUSE #1

C SE SW Sec. 1-32S-9W
Harper County, Kansas

Total Depth: 4480'

Elev: 1531 KB

Comm: 3/1/57
Comp: 3/17/57

Casings:

Cement

8 5/8" @ 218'

150 sacks cement

FORMATION	DEPTH
Red Bed	315
Shale & shells	1455
Lime & shale	3170
Lime	3210
Lime & shale	3692
Sand, lime & shale	3735
Lime	3765
Lime & shale	3945
Lime	4078
Lime & shale	4399
Lime	4480

Tops:	Lansing K.C.	3945
	Mississippi	4399

STATE OF KANSAS)
) ss:
COUNTY OF RUSSELL)

I hereby certify that the above information is true and correct to the best of my knowledge.

C. P. Harker

Subscribed and sworn to before me this 18th day of March, 1957.

Margie Casper
Notary Public

My commission expires: 1-30-61.

PLUGGING			
FILE	SEC	T. 32	R. 9W
BOOK	PAGE	149	LINE 2

3-19-57