


STATE OF KANSAS
STATE CORPORATION COMMISSION

Give All Information Completely
Make Required Affidavit
Mail or Deliver Report to:
Conservation Division
State Corporation Commission
212 No. Market
Wichita, Kansas 67202

WELL PLUGGING RECORD

Barber County. Sec. 33 Twp. 32S Rge. 15 (W)

Location as "NE/CNW/SW" or footage from lines. Ctr SW SW
Lease Owner Champlin Petroleum Company
Lease Name DeGeer Well No. 1
Office Address P. O. Box 308, Ellinwood, Kansas 67526
Character of Well (completed as Oil, Gas or Dry Hole) Dry Hole
Date well completed April 2, 1971
Application for plugging filed April 2, (Verbal) 1971
Application for plugging approved April 2, (Verbal) 1971
Plugging commenced April 3, 1971
Plugging completed April 3, 1971
Reason for abandonment of well or producing formation

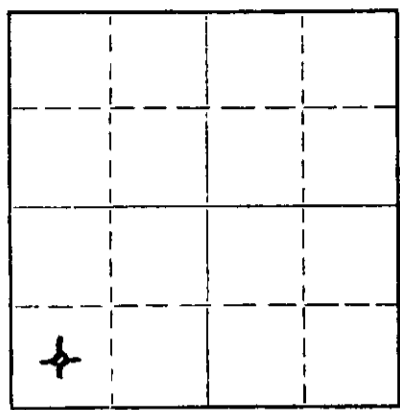

Locate well correctly on above Section Plat

If a producing well is abandoned, date of last production 19
Was permission obtained from the Conservation Division or its agents before plugging was commenced? Yes

Name of Conservation Agent who supervised plugging of this well G. R. Biberstein
Producing formation Depth to top Bottom Total Depth of Well 4780 Feet
Show depth and thickness of all water, oil and gas formations.

OIL, GAS OR WATER RECORDS CASING RECORD

| FORMATION | CONTENT | FROM | TO | SIZE | PUT IN | PULLED OUT |
|-----------|---------|------|----|---------|--------|------------|
| | | | | 13 3/8" | 298' | None |
| | | | | | | |
| | | | | | | |
| | | | | | | |
| | | | | | | |
| | | | | | | |
| | | | | | | |

Describe in detail the manner in which the well was plugged, indicating where the mud fluid was placed and the method or methods used in introducing it into the hole. If cement or other plugs were used, state the character of same and depth placed, from feet to feet for each plug set.

Filled hole with heavy mud from 4780' T.D. to 500'. Pushed plug to 500' and pumped in 40 sacks of cement then filled hole with mud to 275' and pushed plug to 275' and pumped in 30 sacks of cement then mud to 40' and pushed 1/2 sack of hulls and plug to 40' and pumped in 15 sacks of cement filling hole to top. Pumped 2 sacks of cement in rat hole. Job complete at 4:00 a.m. 4/3/71.

RECEIVED
STATE CORPORATION COMMISSION
APR 7 1971
CONSERVATION DIVISION
Wichita, Kansas

(If additional description is necessary, use BACK of this sheet)
Name of Plugging Contractor Leben Drilling, Inc.
Address 815 Wichita Plaza, Wichita, Kansas

STATE OF Kansas, COUNTY OF Barton, ss.
J. W. Meyers (employee of owner) or (conservator) of the above-described well, being first duly sworn on oath, says: That I have knowledge of the facts, statements, and matters herein contained and the log of the above-described well as filed and that the same are true and correct. So help me God.

(Signature) J. W. Meyers, District Operations Manager
P. O. Box 308, Ellinwood, Kansas 67526
(Address)

SUBSCRIBED AND SWORN TO before me this 6th day of April, 1971

N. Kenneth Stivers
Notary Public.

My commission expires 4/16/74

WELL LOG

Company CHAMPLIN PETROLEUM COMPANY

Sec. 33 T. 32S R. 15W

Contractor LEBEN DRILLING, INC.

Loc. C SW SW

Farm DE GEER #1

County Barber

Total Depth 4780


Casing 13 3/8" csg. 48# new set @ 298 w/300 sx. 50-50 poz 2% cc + 100

Commenced March 20, 1971

Production sx sunset

Completed April 3, 1971

D&A

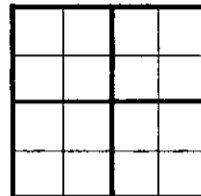

Figures Indicate Bottom of Formations

| | | |
|------|------|-------------------------|
| 0 | 160 | Clay and Shale |
| 160 | 170 | Sand |
| 170 | 340 | Shale |
| 340 | 1080 | Shale, Sand and Red Bed |
| 1080 | 1605 | Shale |
| 1605 | 2175 | Shale and Lime |
| 2175 | 3385 | Lime and Shale |
| 3385 | 3695 | Shale and Lime |
| 3695 | 3975 | Lime and Shale |
| 3975 | 4780 | Lime |
| | 4780 | RTD |

RECEIVED
STATE CORPORATION COMMISSION
APR 8 1971
CONSERVATION DIVISION
Wichita, Kansas

State of Kansas
County of SEDGWICK

SS

I, Leslie Kite of Leben Drilling, Inc., upon oath state that the above and foregoing is a true and correct copy of the log of the #1 DE GEER Well.

Leslie Kite



sworn to before me this 7th day of April, 1971

My Commission Expires: Feb. 20, 1975

Brenda A. Vanderfecht
Brenda A. Vanderfecht