

15-007-01766-0000

STATE OF KANSAS  
STATE CORPORATION COMMISSION

WELL PLUGGING RECORD

Give All Information Completely  
Make Required Affidavit  
Mail or Deliver Report to:  
Conservation Division  
State Corporation Commission  
800 Bitting Building  
Wichita, Kansas

OR

FORMATION PLUGGING RECORD

Strike out upper line  
when reporting plugging  
off formations.

Barber County. Sec. 26 Twp. 32s Rge. (E) 15 (W)

Location as "NE $\frac{1}{4}$ NW $\frac{1}{4}$ SW $\frac{1}{4}$ " or footage from lines SW $\frac{1}{4}$ -SW $\frac{1}{4}$ -NW $\frac{1}{4}$

Lease Owner Champlin Refining Company

Lease Name Hildebrand Well No. 12

Office Address P.O. Drawer #552, Enid, Oklahoma.

Character of Well (completed as Oil, Gas or Dry Hole) Dry hole

Date well completed April 24, 1948

Application for plugging filed February 10, 1949

Application for plugging approved 19


Plugging commenced February 22, 1949

Plugging completed March 3, 1949

Reason for abandonment of well or producing formation At time of completion well produced 15 Bbl. per hr. of oil but immediately (Over)

If a producing well is abandoned, date of last production 19

Was permission obtained from the Conservation Division or its agents before plugging was commenced? Yes

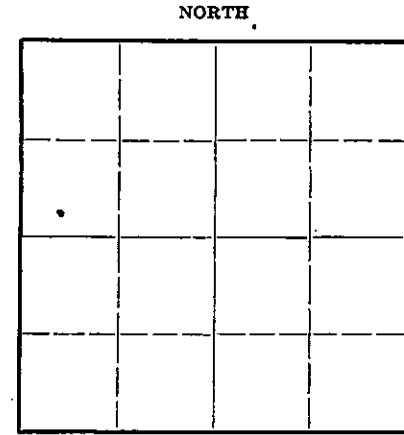

Locate well correctly on above Section Plat

Name of Conservation Agent who supervised plugging of this well C. D. Stough, Great Bend, Kansas.

Producing formation Depth to top Bottom Total Depth of Well 5002' Feet

Show depth and thickness of all water, oil and gas formations.

OIL, GAS OR WATER RECORDS

CASING RECORD

Formation	Content	From	To	Size	Put In	Pulled Out
				10 $\frac{3}{4}$ " OD	465'	None
				8 5/8" OD	800'	None
				5 $\frac{1}{2}$ " OD	5002'	3297'

Describe in detail the manner in which the well was plugged, indicating where the mud fluid was placed and the method or methods used in introducing it into the hole. If cement or other plugs were used, state the character of same and depth placed, from feet to feet for each plug set.

set cement plug in bottom using 5 sacks of cement then filled hole with heavy mud from top of plug to 250' and set rock plug 10' and set cement plug using 20 sacks of cement then mudded hole from top of plug to 30' and set cement plug from 30' to bottom of cellar using 10 sacks of cement.

RECEIVED  
Conservation Div.  
MAR 8 - 1949  
3-8-49  
STATE CORPORATION COMMISSION  
WICHITA, KANSAS

(If additional description is necessary, use BACK of this sheet)

Correspondence regarding this well should be addressed to Champlin Refining Company

Address P. O. Drawer #552, Enid, Oklahoma.

STATE OF ~~Barber~~ Kansas, COUNTY OF Barton, ss.

S. P. Hall

(employee of owner) or (owner or operator) of the above-described well,

being first duly sworn on oath, says: That I have knowledge of the facts, statements, and matters herein contained and the log of the above-described well as filed and that the same are true and correct. So help me God.

(Signature) S. P. Hall

P. O. Box 167, Ellinwood, Kansas.

SUBSCRIBED AND SWORN to before me this 7th day of March 1949

My commission expires October 24, 1951

PLUGGING  
FILE NO. 26-12-32-19  
BOOK PAGE 87 LINE 22

Notary Public.

CHAMPLIN REFINING COMPANY  
HILDEBRAND #12

2310' from the North Line and 630' from the  
West Line of Section 26-32S-15W  
Barber County, Kansas

0'	-	100'	Red Bed & Shells
100'	-	480'	Red Bed & Shells
480'	-	810'	Red Bed & Shells
810'	-	918'	Red Bed & Shells
918'	-	1000'	Shale & Gyp
1000'	-	1240'	Shale & Gyp
1240'	-	1440'	Shale & Gyp
1440'	-	1720'	Shale & Shells
1720'	-	1885'	Shale & Shells
1885'	-	2070'	Shale & Shells
2070'	-	2085'	Shale
2085'	-	2180'	Shale & Lime
2180'	-	2260'	Shale & Lime
2260'	-	2320'	Lime & Shale
2320'	-	2410'	Lime & Shale
2410'	-	2490'	Shale & Lime
2490'	-	2555'	Lime & Shale
2555'	-	2600'	Lime
2600'	-	2645'	Shale & Lime
2645'	-	2690'	Lime & Shale
2690'	-	2750'	Lime & Shale
2750'	-	2830'	Shale
2830'	-	2910'	Shale & Lime
2910'	-	2970'	Shale
2970'	-	30370'	Shale
30370'	-	3170'	Shale & Lime
3170'	-	3240'	Shale
3240'	-	3345'	Shale & Lime
3345'	-	3410'	Lime & Shale
3410'	-	3460'	Lime
3460'	-	3595'	Lime & Shale
3595'	-	3695'	Lime & Shale
3695'	-	3735'	Lime & Shale
3735'	-	3825'	Lime & Shale
3825'	-	3905'	Shale & Lime
3905'	-	3980'	Shale
3980'	-	4020'	Shale & Lime
4020'	-	4080'	Lime & Shale
4080'	-	4135'	Lime & Shale
4135'	-	4180'	Lime & Shale
4180'	-	4230'	Shale & Lime
4230'	-	4280'	Lime & Shale
4280'	-	4315'	Lime & Shale
4315'	-	4350'	Shale & Lime
4350'	-	4385'	Lime
4385'	-	4470'	Lime
4470'	-	4510'	Lime
4510'	-	4555'	Lime
4555'	-	4585'	Lime
4585'	-	4615'	Lime
4615'	-	4645'	Lime & Shale
4645'	-	4670'	Lime
4670'	-	4705'	Lime
4705'	*	4730'	Lime & Shale
4730'	-	4760'	Lime
4760'	-	4780'	Lime
4780'	-	4810'	Lime & Shale
4810'	-	4855'	Lime & Shale

2-11-49

PLUGGING  
FOR SEC 26 T32 R15W  
BOOK PAGE 5 LINE 22

4855'	-	4885'	Shale & Lime
4885'	-	4920'	Lime & Shale
4920'	-	4945'	Lime & Shale
4945'	-	4950'	Lime
4950'	-	4963'	Lime
4963'	-	4975'	Lime
4975'	-	4990'	Lime & Chert
4990'	-	5002'	Lime & Chert
5002'			Total Depth

2-11-47