


STATE OF KANSAS
STATE CORPORATION COMMISSION

WELL PLUGGING RECORD

Give All Information Completely
Make Required Affidavit
Mail or Deliver Report to
Conservation Division
State Corporation Comm.
245 North Water
Wichita, KS 67202

Barber County, Sec. 26 Twp. 32 Rge. 15 E/W
Location as "NE/CNW $\frac{1}{4}$ SW $\frac{1}{4}$ " or footage from lines _____
C S/2 SW SW
Lease Owner Raymond Oil Co., Inc.
Lease Name Hildebrand #10 Well No. _____
Office Address Wichita, Kansas 67202
Character of Well (Completed as Oil, Gas or Dry Hole) _____

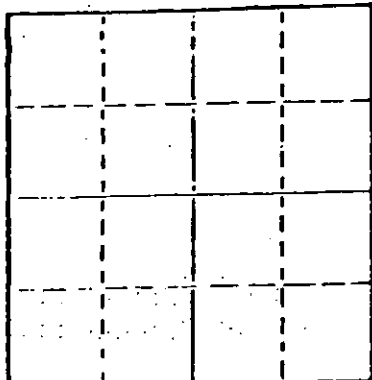

Locate well correctly on above
Section Plat

Date Well completed 19____
Application for plugging filed 19____
Application for plugging approved 19____
Plugging commenced 6/16/77 19____
Plugging completed 6/22/77 19____
Reason for abandonment of well or producing formation
depleted.

If a producing well is abandoned, date of last production 19____

Was permission obtained from the Conservation Division or
its agents before plugging was commenced? yes

Name of Conservation Agent who supervised plugging of this well Metz
Producing formation _____ Depth to top _____ Bottom _____ Total Depth of Well 4983
Show depth and thickness of all water, oil and gas formations.

OIL, GAS OR WATER RECORDS

CASING RECORD

FORMATION	CONTENT	FROM	TO	SIZE	PUT IN	PULLED OUT
				9-5/8	527	none
				5 1/2"	4983	2223'

Describe in detail the manner in which the well was plugged, indicating where the mud fluid was placed and the method or methods used in introducing it into the hold. If cement or other plugs were used, state the character of same and depth placed, from _____ feet to _____ feet for each plug set.

Sanded to 4900' and set 5 sacks cement. Shot pipe at 3000', 2814', 2624', 2392', 2312', 2230', pulled 73 joints. Set rock bridge at 270' and ran 5 yards ready mix.

PLUGGING COMPLETE.

RECEIVED
STATE CORPORATION COMMISSION
7-11-77
JUL 11 1977
CONSERVATION DIVISION
Wichita, Kansas

(If additional description is necessary, use BACK of this sheet)
Name of Plugging Contractor VOTH CASING PULLING
CHASE, KANSAS

STATE OF KANSAS COUNTY OF RICE, ss.
WALTER VOTH (employee of owner) or (owner or operator)
of the above-described well, being first duly sworn on oath, says: That I have knowledge of the facts, statements, and matters herein contained and the log of the above-described well as filed and that the same are true and correct. So help me God.

(Signature) Walter Voth
CHASE, KANSAS
(Address)

SUBSCRIBED AND SWORN TO before me this 7th day of July, 19 77

My commission expires

NOTARY PUBLIC
MARGARET MELCHER
Rice County, Ks.
My Comm. Exp. Feb. 15, 1979

Margaret Melcher
Notary Public.

15-057-10132-0000
 WELL LOG BUREAU - KANSAS GEOLOGICAL SOCIETY
 412 Union National Bk. Bldg., Wichita, Kansas

COPY


Company - CHAMPLIN REFG. CO. ✓
 Farm - Hildebrand No. 10

SEC. 26 T. 32 R. 15W

C.S. 21 SW SW
 350' SL & 640' WL-SW 1/4

County, Barber

KANSAS

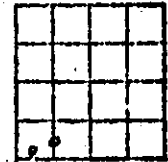

Total Depth 4983'
 Comm. 12-21-46 Comp. 1-15-47
 Shot or Treated.
 Contractor.
 Issued. 3-15-47

CASING:

9 5/8" 527' Cem.w/250 sx.
 5 1/2" 4983' Cem.w/450 sx.

Elevation. _____

Production. Pot. 2911 Bbls.
 Plus 2% wtr.

Figures indicate Bottom of Formations.

shale & shells	0-75
redbed & lime shells	521
shale & shells	1450
redbed, shale & shells	1725
shale & anhydrite	2070
shale & lime	2545
shale & lime sdy	2640
shale & lime	4983
Total Depth	

Tops:	
Lansing	4140
Kansas City	4230
Mississippian	4710
Viola (Dolomite)	4953
Crystalline Viola	4965

RECEIVED
 STATE CORPORATION COMMISSION

JUN 02 1977
 6-2-77
 CONSERVATION DIVISION
 Wichita, Kansas