

STATE OF KANSAS
STATE CORPORATION COMMISSION

Give All Information Completely
Make Required Affidavit
Mail or Deliver Report to:
Conservation Division
State Corporation Commission
212 No. Market
Wichita, Kansas 67202


WELL PLUGGING RECORD

Form CP-4

15-115, 21029-0000
20129

Location as "NE/CNW/SW" or footage from lines Marion County, Sec. 29 Twp. 17 Rge. 4 (E) (W) SE SE NE
Lease Owner Slusser Drilling Co.
Lease Name Dienes Well No. 5
Office Address Box 275 Marion, Kansas
Character of Well (completed as Oil, Gas or Dry Hole) Disposal
Date well completed 7/28/70 19
Application for plugging filed Aug. 23, 1978 19
Application for plugging approved Aug. 25, 1978 19
Plugging commenced Sept. 2, 1978 19
Plugging completed Sept. 11, 1978 19
Reason for abandonment of well or producing formation Abandoned Lease

If a producing well is abandoned, date of last production Never Produced 19
Was permission obtained from the Conservation Division or its agents before plugging was commenced? Yes

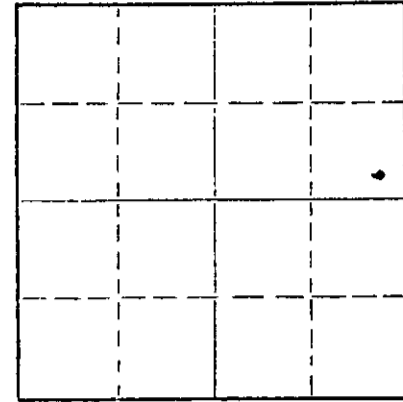

Locate well correctly on above Section Plat

Name of Conservation Agent who supervised plugging of this well Merle Hickey
Producing formation _____ Depth to top _____ Bottom _____ Total Depth of Well 2746 Feet
Show depth and thickness of all water, oil and gas formations.

OIL, GAS OR WATER RECORDS

CASING RECORD

FORMATION	CONTENT	FROM	TO	SIZE	PUT IN	PULLED OUT
Hunton Lime	Water	2687	2746	8 5/8	204	None
				6	2690	1600

Describe in detail the manner in which the well was plugged, indicating where the mud fluid was placed and the method or methods used in introducing it into the hole. If cement or other plugs were used, state the character of same and depth placed, from _____ feet to _____ feet for each plug set.

Filled hole with sand to 2680. Dumped 5 sacks cement on sand. Set rock bridge at 225 ft. Dumped 20 sacks cement on bridge. Filled hole with mud to 40 ft. Set 10 ft. rock bridge on mud. Filled to surface with cement.

RECEIVED
STATE CORPORATION COMMISSION

SEP 15 1978


CONSERVATION DIVISION
Wichita, Kansas

(If additional description is necessary, use BACK of this sheet)

Name of Plugging Contractor _____
Address _____

STATE OF Kansas, COUNTY OF Marion, ss.
Billy H. Slusser (employee of owner) or (owner or operator) of the above-described well, being first duly sworn on oath, says: That I have knowledge of the facts, statements, and matters herein contained and the log of the above-described well as filed and that the same are true and correct. So help me God.

(Signature) Billy H. Slusser
Box 275 Marion, Kansas (Address)

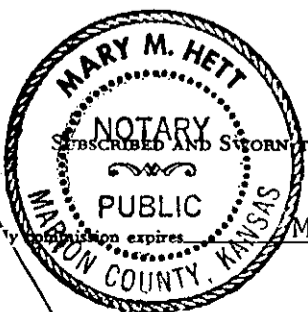

before me this 13th day of September, 19 78

My commission expires May 27, 1980

Mary M. Hett Notary Public.

Company Slusser Drilling Co.
Contractor Slusser Drilling Co.
Farm Deines #5
8 5/8 @ 204
6 " @2690

Commenced 7/24/70
Completed 7/28/70
SE SE NE 29/17/4
Marion County, Kansas

Surface Soil	5
Shale & Shells	105
Lime & Shale	580
Shale & Shells	915
Shells & Shale	1130
Shale & Lime	1330
Lime & Shale	1575
Shale & Lime	1700
Lime & Shale	1770
Shale & Lime	1835
Lime	2165
Lime & Shale	2280
Shale & Lime	2399
Chat	2473
Lime	2533
Shale	2687
Lime	2746 Rotary T.D.

RECEIVED
STATE COMMISSION

AUG 25 1978

CONSERVATION DIVISION
Wichita, Kansas