


STATE OF KANSAS
STATE CORPORATION COMMISSION

Give All Information Completely
Make Required Affidavit
Mail or Deliver Report to:
Conservation Division
State Corporation Commission
212 No. Market
Wichita, Kansas

15-115-20010-0000 R
Form CP-4
WELL PLUGGING RECORD

NORTH

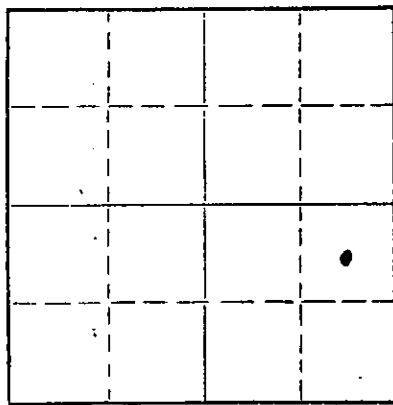

Locate well correctly on above
Section Plat

Marion County, Sec. 24 Twp. 17 Rge. 4 (E) (W)
Location as "NE/CNWKSWK" or footage from lines. C NE SE
Lease Owner Slusser Drilling Company
Lease Name Krause Well No. 1
Office Address P. O. Box 275, Marion, Kansas 66861
Character of Well (completed as Oil, Gas or Dry Hole) Dry Hole
Date well completed 4-15, 19 67
Application for plugging filed 4-15, 19 67
Application for plugging approved 4-15, 19 67
Plugging commenced 4-15, 19 67
Plugging completed 4-15, 19 67
Reason for abandonment of well or producing formation Dry Hole

If a producing well is abandoned, date of last production 19
Was permission obtained from the Conservation Division or its agents before plugging was commenced? Yes

Name of Conservation Agent who supervised plugging of this well Hugh Scott
Producing formation _____ Depth to top _____ Bottom _____ Total Depth of Well 2344 Feet
Show depth and thickness of all water, oil and gas formations.

OIL, GAS OR WATER RECORDS

CASING RECORD

FORMATION	CONTENT	FROM	TO	SIZE	PUT IN	PULLED OUT
				8 5/8"	210'	None

Describe in detail the manner in which the well was plugged, indicating where the mud fluid was placed and the method or methods used in introducing it into the hole. If cement or other plugs were used, state the character of same and depth placed, from _____ feet to _____ feet for each plug set.

Filled hole with mud to 210'
Set bridge on mud
Dumped 25 sacks of cement on bridge
Filled hole with mud to 30'
Set plug on mud
Filled to surface with cement
2 sacks in rat hole
Plugging completed.

APR 24 1967
CONSERVATION DIVISION
Wichita, Kansas

(If additional description is necessary, use BACK of this sheet)
Name of Plugging Contractor Slusser Drilling Company
Address P. O. Box 275, Marion, Kansas 66861

STATE OF Kansas, COUNTY OF Marion, ss.
Billy H. Slusser (employee of owner) or (owner or operator) of the above-described well, being first duly sworn on oath, says: That I have knowledge of the facts, statements, and matters herein contained and the log of the above-described well as filed and that the same are true and correct. So help me God.

(Signature) Billy H. Slusser
Box 275, Marion, Kansas 66861
(Address)

SUBSCRIBED AND SWORN TO before me this 15th, day of April, 19 67

My commission expires July 6, 1967
(Mrs.) Vivian I. Mott Conyers Notary Public.

Q

DRILLERS LOG

Company
Contractor
Farm
8 5/8

Slusser Drilling Company
Slusser Drilling Company
Krause #1
@ 210

Commenced 4-11-67
Completed 4-15-67
C NE SE 24-17-4E
Marion Co., Kansas

Surface Soil	5
Shale & Shells	70
Lime & Shale	503
Shale & Shells	1250
Shale & Lime	1445
Lime	1580
Lime & Shale	1765
Lime	2120
Lime & Shale	2304
Chat	2341
Lime	2344 Rotary T. D.

RECEIVED
S.M. CONSERVATION COMMISSION

APR 24 1967

CONSERVATION DIVISION
Wichita, Kansas