


WELL PLUGGING RECORD

Give All Information Completely
Make Required Affidavit
Mail or Deliver Report to:
Conservation Division
State Corporation Commission
800 Bitting Building
Wichita, Kansas

NORTH

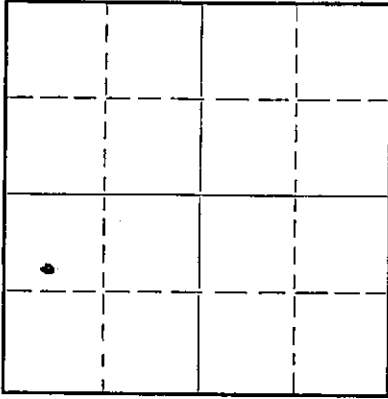

Locate well correctly on above
Section Plat

Barber County, Sec. 26 Twp. 32s Rge. (E) (W) 15w
Location as "NE/CNW $\frac{1}{4}$ /SW $\frac{1}{4}$ " or footage from lines 1630' from South line,
Lease Owner Champlin Refining Co. (570' from West line, Sec. 26.
Lease Name Baird Well No. 3
Office Address P. O. Dr. #552, Enid, Oklahoma.
Character of Well (completed as Oil, Gas or Dry Hole) Oil & Gas
Date well completed April 4, 1947
Application for plugging filed December 20, 1950
Application for plugging approved January 11, (Verbal) 1951
Plugging commenced January 12, 1951
Plugging completed January 18, 1951
Reason for abandonment of well or producing formation Non-productive

If a producing well is abandoned, date of last production January 3, 1951
Was permission obtained from the Conservation Division or its agents before plugging was commenced? Yes

Name of Conservation Agent who supervised plugging of this well Mr. C. D. Stough, Great Bend, Kansas.
Producing formation _____ Depth to top _____ Bottom _____ Total Depth of Well _____ Feet
Show depth and thickness of all water, oil and gas formations.

OIL, GAS OR WATER RECORDS

CASING RECORD

Formation	Content	From	To	Size	Put In	Pulled Out
				10 $\frac{3}{4}$ " OD	420'	None
				5 $\frac{1}{2}$ " OD	5011'	3517' 8"

Describe in detail the manner in which the well was plugged, indicating where the mud fluid was placed and the method or methods used in introducing it into the hole. If cement or other plugs were used, state the character of same and depth placed, from _____ feet to _____ feet for each plug set.

Filled hole with crushed rock from 5011' T.D. to 4975' and set cement plug on top of rock from 4975' to 4950' using 5 sacks of cement then filled hole with heavymud from 4950' to 300' and set permanent rock bridge from 300' to 290' and set cement plug from 290' to 250' using 20 sacks of cement then filled hole with heavy mud from 250' to 30' and set rock bridge from 30' to 25' then set cement plug in top from 25' to bottom of cellar using 10 sacks of cement.

RECEIVED
STATE CORPORATION COMMISSION
2-13-51
FEB 13 1951
CONSERVATION DIVISION
Wichita, Kansas

(If additional description is necessary, use BACK of this sheet)

Correspondence regarding this well should be addressed to Champlin Refining Company
Address P. O. Dr. #552,
Enid, Oklahoma.

STATE OF Kansas, COUNTY OF Barton, ss.
S. P. Hall (employee of owner) or ~~owner~~ of the above-described well,

being first duly sworn on oath, says: That I have knowledge of the facts, statements, and matters herein contained and the log of the above-described well as filed and that the same are true and correct. So help me God.

(Signature) S. P. Hall
P. O. Box 167, Ellinwood, Kansas.
(Address)

SUBSCRIBED AND SWORN to before me this 12th day of February, 1951

My commission expires October 24, 1951

M. Kenneth Sturis
Notary Public.

PLUGGING
FILE SEC 26 T 32 R 15
BOOK PAGE 52 LINE 15

BAIRD NO. 3 15-067-10133-0000
 CHAMPAIN REFINING COMPANY
 1650' from the South Line
 570' from West Line
 BARBER COUNTY, KANSAS
 Sec. 26, T. 32 S.
 Range 15 W

0'	-	350'	Red Bed, Shale
350'	-	420'	Red Bed, Shale
420'	-	905'	Red Bed, Shells.
905'	-	1270'	Red Bed, Shale, Shells
1270'	-	1470'	Shale & Anhydrite.
1470'	-	1625'	Shale, Shells.
1625'	-	1925'	Shale & Shells.
1925'	-	2060'	Shale & Shells.
2060'	-	2160'	Shale & Lime.
2160'	-	2260'	Shale & Lime.
2260'	-	2300'	Shale & Lime.
2300'	-	2335'	Lime & Shale.
2335'	-	2445'	Lime & Shale.
2445'	-	2490'	Lime & Shale.
2490'	-	2570'	Shale & Lime.
2570'	-	2605'	Shale & Lime.
2605'	-	2685'	Shale & Lime.
2685'	-	2735'	Shale & Lime.
2735'	-	2800'	Shale & Lime.
2800'	-	2860'	Shale & Sandy Lime.
2860'	-	2930'	Shale & Sandy Lime.
2930'	-	2990'	Shale & Sandy Lime.
2990'	-	3150'	Lime and Shale.
3150'	-	3220'	Shale & Lime.
3220'	-	3250'	Shale & Lime.
3250'	-	3300'	Shale & Lime.
3300'	-	3360'	Shale & Lime.
3360'	-	3390'	Shale & Lime.
3390'	-	3460'	Shale & Shells.
3460'	-	3520'	Shale & Lime.
3520'	-	3570'	Shale & Lime.
3570'	-	3700'	Shale & Lime.
3700'	-	3745'	Shale & Lime.
3745'	-	3780'	Shale & Lime.
3780'	-	3865'	Shale & Lime.
3865'	-	3960'	Shale & Lime.
3960'	-	4010'	Lime & Shale.
4010'	-	4045'	Lime & Shale.
4045'	-	4075'	Lime & Shale.
4075'	-	4125'	Lime.
4125'	-	4145'	Lime.
4145'	-	4245'	Lime & Shale.
4245'	-	4270'	Lime.
4270'	-	4305'	Lime & Shale.
4305'	-	4340'	Lime.
4340'	-	4360'	Lime.
4360'	-	4395'	Lime.
4395'	-	4445'	Lime & Shale.
4445'	-	4480'	Lime & Shale.
4480'	-	4500'	Lime.
4500'	-	4550'	Lime & Shale.
4550'	-	4565'	Lime.
4565'	-	4590'	Lime.
4590'	-	4610'	Lime.
4610'	-	4625'	Lime.
4625'	-	4655'	Lime.
4655'	-	4675'	Lime.
4675'	-	4690'	Lime.
4690'	-	4715'	Lime.
4715'	-	4740'	Lime.
4740'	-	4775'	Lime.
4775'	-	4795'	Lime.
4795'	-	4805'	Lime & Shale
4805'	-	4830'	Lime & Shale
4830'	-	4865'	Lime.
4865'	-	4885'	Lime.
4885'	-	4910'	Lime.
4910'	-	4965'	Lime & Shale.
4965'	-	4997'	Lime & Shale.
4997'	-	5011'	Lime.
5011'	-	TOTAL	DEPTH

PLUGGING
 SEC 26 T 32 R 15 W
 PAGE 52 LINE 15

12-29-50