

15-115-20173-0000


STATE OF KANSAS
STATE CORPORATION COMMISSION

WELL PLUGGING RECORD

Give All Information Completely
Make Required Affidavit
Mail or Deliver Report to
Conservation Division
State Corporation Comm.
245 North Water
Wichita, KS 67202

Marion County, Sec. 20 Twp. 17 Rge. 4 E E/W
Location as "NE/CNW $\frac{1}{2}$ SW $\frac{1}{2}$ " or footage from lines
C NW NE

Lease Owner Slusser Drilling Co.
Lease Name Shields Well No. 1
Office Address P.O. Box 275 Marion, Kans. 66861
Character of Well (Completed as Oil, Gas or Dry Hole) oil

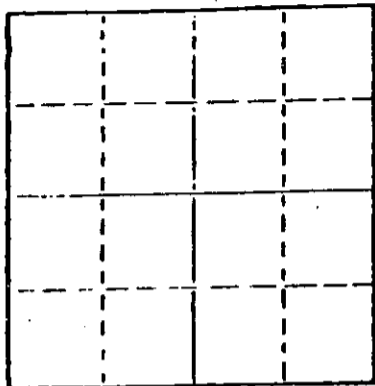

Locate well correctly on above
Section Plot

Date Well completed 3-20 1972
Application for plugging filed 12-1 1977
Application for plugging approved 12-2 1977
Plugging commenced 12-6 1977
Plugging completed 12-12 1977
Reason for abandonment of well or producing formation _____

If a producing well is abandoned, date of last production
19 _____

Was permission obtained from the Conservation Division or
its agents before plugging was commenced? yes

Name of Conservation Agent who supervised plugging of this well Hugh Scott
Producing formation _____ Depth to top _____ Bottom _____ Total Depth of Well 2420'
Show depth and thickness of all water, oil and gas formations.

OIL, GAS OR WATER RECORDS

CASING RECORD

FORMATION	CONTENT	FROM	TO	SIZE	PUT IN	PULLED OUT
				5 1/2"		2163'

Describe in detail the manner in which the well was plugged, indicating where the mud fluid
was placed and the method or methods used in introducing it into the hold. If cement or other
plugs were used, state the character of same and depth placed, from _____ feet to
_____ feet for each plug set. Plugged off bottom of hole with sand. Sand from
2420' to 2350'. Dumped 5 sx of cement. Mudded
hole to 180'. Made 10' of rock bridge. Dumped
25 sx of cement. Mudded hole to 40'/ Made 10'
of rock bridge. Dumped 10 sx of cement, filling
to the bottom of the celler.

RECEIVED
STATE CORPORATION COMMISSION
DEC 16 1977

CONSERVATION DIVISION
Wichita, Kansas

(If additional description is necessary, use BACK of this sheet)

Name of Plugging Contractor Art Lamb Casing Pulling Inc.
2809 King St. Hutchinson, Kansas 67501

STATE OF Kansas COUNTY OF Reno, ss.
Art Lamb (employee of owner) or (owner or operator) of the above-described

well, being first duly sworn on oath, says: That I have knowledge of the facts, statements, and matters herein contained and the log of the
above-described well as filed and that the same are true and correct. So help me God.

(Signature) Art Lamb
2809 King St. Hutchinson, Kansas
(Address)

SUBSCRIBED AND SWORN TO before me this 15th day of December, 1977

My commission expires December 31, 1977

Judy Lamb
Notary Public.

DRILLERS LOG

Company
Contractor
Farm
8 5/8
5 1/2

Slusser Drilling Company
Slusser Drilling Company
Shields #1
@ 152 100 *ref*
@ 2370 30 *ref*

Commenced 3/17/72
Completed 3/20/72
C NW NE 20-17-4 E
Marion County, Kansas

Surface soil	5
Shale and shells	40
Lime and shale	525
Shale and lime	740
Shale and shells	1025
Shells, shale & lime	1460
Shale and lime	1630
Shale, sand & lime	1812
Lime	2120
Shale	2130
Lime and shale	2190
Shale and lime	2363
Chat	2416
Lime	2420 Rotary T.D.

RECEIVED
STATE CORPORATION COMMISSION

DEC 05 1977

CONSERVATION DIVISION
Wichita, Kansas