


15-007-00176-0000

STATE OF KANSAS
STATE CORPORATION COMMISSION

Give All Information Completely
Make Required Affidavit
Mail or Deliver Report to:
Conservation Division
State Corporation Commission
800 Bitting Building
Wichita, Kansas

WELL PLUGGING RECORD

NORTH

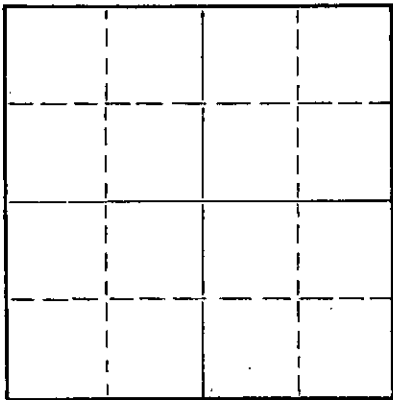

Locate well correctly on above
Section Plat

Barber County, Sec. 31 Twp. 32S Rge. 11W (#) (W)
Location as "NE/CNWxSWx" or footage from lines NE NE NE
Lease Owner Aurora Gasoline Company
Lease Name McClure Well No. #1
Office Address 802 Union Nat'l. Bk. Bldg., Wichita 2, Kansas
Character of Well (completed as Oil, Gas or Dry Hole) Dry Hole
Date well completed 7-18 1955
Application for plugging filed 7-18 1955
Application for plugging approved 7-18 1955
Plugging commenced 7-18 1955
Plugging completed 7-18 1955
Reason for abandonment of well or producing formation DRY

If a producing well is abandoned, date of last production 19
Was permission obtained from the Conservation Division or its agents before plugging was commenced? Yes.

Name of Conservation Agent who supervised plugging of this well Merle Rives
Producing formation _____ Depth to top _____ Bottom _____ Total Depth of Well 4850 Feet
Show depth and thickness of all water, oil and gas formations.

OIL, GAS OR WATER RECORDS

CASING RECORD

FORMATION	CONTENT	FROM	TO	SIZE	PUT IN	PULLED OUT
				8 5/8"	205'	none

Describe in detail the manner in which the well was plugged, indicating where the mud fluid was placed and the method or methods used in introducing it into the hole. If cement or other plugs were used, state the character of same and depth placed, from _____ feet to _____ feet for each plug set.

Filled hole with heavy mud to bottom of surface pipe 200'

Bridge hole @ 200' and cement with 20 ~~XXX~~ sacks.

Filled hole with heavy mud to 20', Cemented with 10 sacks

to bottom of cellar.

(If additional description is necessary, use BACK of this sheet)

Name of Plugging Contractor S. A. Berwick Drilling Company
Address P. O. Box 64, Great Bend, Kansas

STATE OF KANSAS, COUNTY OF SEDGWICK, ss.
Leonard Olds (employee of owner) or (owner or operator) of the above-described well, being first duly sworn on oath, says: That I have knowledge of the facts, statements, and matters herein contained and the log of the above-described well as filed and that the same are true and correct. So help me God.

(Signature) Leonard Olds
802 Union National Bank Bldg., Wichita, Ks.
(Address)

SUBSCRIBED AND SWORN to before me this 28th day of July, 1955

My commission expires October 23, 1957

Frances C. Newlon
Notary Public.

PLUGGING
FILE SEC. 31 T. 32 R. 11W
BOOK PAGE 135 LINE 42

RECEIVED
STATE CORPORATION COMMISSION

CONCERN 7-27-55
Wichita, Kansas

1 McClure

NE NE NE Sec 31-32-11
 Barber County, Kansas
 Elevation:
 Initial Prod:
 Contractor: S.A. Berwick
 Drilling Co.

Total Depth: 4850'
 Commenced R.D.: 6-28-55
 Completed R.D.: 7-18-55

8 5/8" at 205'

Strata	Depth
Sand	0 - 40
Shale & Shells	40 - 205
Red Bed & Shale	205 - 645
Shale & Shells	645 - 1480
Lime	1480 - 1514
Shale & Shells	1514 - 1550
Lime	1550 - 1625
Lime & Shale	1625 - 1860
Lime	1860 - 1940
Lime & Shale	1940 - 2130
Shale & Sand	2130 - 3595
Shale	3595 - 3600
Sand	3600 - 3695
Lime	3695 - 3738
Lime & Churt	3738 - 4395
Lime	4395 - 4418
Lime & Shale	4418 - 4600
Lime	4600 - 4677
Sand & Shale	4677 - 4714
Sand	4714 - 4760
Shale	4760 - 4823
Lime	4823 - 4850

I hereby certify the above a true and correct log of said well as reflected by the daily drilling report.

S.A. Berwick Drilling Co.

By S.A. Berwick
 S.A. Berwick Owner

Signed and sworn to in my presence this 27 day of July, 1955 by S.A. Berwick owner of the S.A. Berwick Drilling Co.

John W. Ross
 Notary Public

NOTARY PUBLIC
 STATE OF KANSAS

My commission expires April 11, 1959

7-29-55

PLUGGING
 FILE SEC-31-32-11W
 BOOK PAGE 132 LINE 42