


WELL PLUGGING RECORD

Give All Information Completely
Make Required Affidavit
Mail or Deliver Report to:
Conservation Division
State Corporation Commission
211 No. Broadway
Wichita, Kansas

NORTH

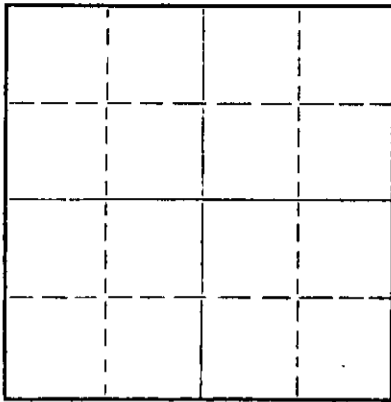

Locate well correctly on above
Section Plat

Barber County, Sec. ³¹~~30~~ Twp. 32S Rge. 11W (E) (W)

Location as "NE/CNW/SW" or footage from lines ~~G-SW-SE~~ NW

Lease Owner Sioux Petroleum Company

Lease Name Drumm Well No. 1

Office Address 104 East Kansas, Medicine Lodge, Ks.

Character of Well (completed as Oil, Gas or Dry Hole) Dry Hole

Date well completed 11-21-65 19

Application for plugging filed 11-21-65 19

Application for plugging approved 11-21-65 19

Plugging commenced 11-21-65 19

Plugging completed 11-21-65 19

Reason for abandonment of well or producing formation Dry Hole

If a producing well is abandoned, date of last production 19

Was permission obtained from the Conservation Division or its agents before plugging was commenced? yes

Name of Conservation Agent who supervised plugging of this well Archie Elving, Pratt, Kansas

Producing formation _____ Depth to top _____ Bottom _____ Total Depth of Well 3735 Feet

Show depth and thickness of all water, oil and gas formations.

OIL, GAS OR WATER RECORDS

CASING RECORD

FORMATION	CONTENT	FROM	TO	SIZE	PUT IN	PULLED OUT
				8 5/8"	211'	none

Describe in detail the manner in which the well was plugged, indicating where the mud fluid was placed and the method or methods used in introducing it into the hole. If cement or other plugs were used, state the character of same and depth placed, from _____ feet to _____ feet for each plug set.

Bottom hole plug set @ 200' with 25 sacks cement
Top plug set @ 40' with 10 sacks cement
2 sks. cement in rathole

STATE CORPORATION COMMISSION

NOV 29 1965
11-29-65
CONSERVATION DIVISION
Wichita, Kansas

(If additional description is necessary, use BACK of this sheet)

Name of Plugging Contractor Leben Drilling, Inc.
Address Box 486, Great Bend, Kansas 67530

STATE OF ~~KANSAS~~ KANSAS, COUNTY OF BARTON, ss.
Leslie Kite

(employee of owner) or (owner or operator) of the above-described well, being first duly sworn on oath, says: That I have knowledge of the facts, statements, and matters herein contained and the log of the above-described well as filed and that the same are true and correct. So help me God.

(Signature) Leslie Kite

P. O. Box 486, Great Bend, Kansas
(Address)

SUBSCRIBED AND SWORN TO before me this 23rd day of November, 1965.

My commission expires April 1, 1967

Gloria D. [Signature]
Notary Public.

DRILLER'S LOG

COMPANY: Sioux Petroleum Company
 CONTRACTOR: LEBEN DRILLING, INC.
 FARM: DRUMM #1
 LOCATION: C SW SE Sec. 30-32S-11W
 BARBER COUNTY, KANSAS
 COMMENCED: 11-15-65
 COMPLETED: 11-21-65

0	57	Sand
57	720	Redbed, Shale
720	1560	Shale, Shells
1560	1850	Lime
1850	2055	Lime, Shale
2055	2143	Lime
2143	2595	Shale, Shells
2595	2980	Shale, Lime
2980	3540	Lime, Shale
3540	3562	Sand
3562	3735	Lime, Shale
	<u>3735</u>	<u>RTD - D. & A.</u>

NOV 29 1965
 11-29-65
 CONSERVATION DIVISION
 STATE OF KANSAS

Set 8 5/8" used surface casing @ 211' with 200 sacks 60-40 Posmix
 Sunset 2% Gel

I, Leslie Kite, do hereby certify that the above and foregoing is a true and correct copy of the log of the Drumm #1 well located C SW SE of Section 30, Township 32 South, Range 11 West, Barber County, Kansas, as reflected by the records of Leben Drilling, Inc.

Leslie Kite

Leslie Kite

STATE OF KANSAS)
) SS
 COUNTY OF BARTON)

Subscribed and sworn to and before me, a Notary Public, in and for Barton County, Kansas, this 23rd day of November, 1965.

Ulanda Nichols

Ulanda Nichols

My Commission Expires:
 April 1, 1967