


STATE OF KANSAS  
STATE CORPORATION COMMISSION

Give All Information Completely  
Make Required Affidavit  
Mail or Deliver Report to:  
Conservation Division  
State Corporation Commission  
212 North Market, Insurance Bldg.  
Wichita, Kansas

WELL PLUGGING RECORD

RABER County, Sec. 30 Twp. 32 Rge. 11 (E) (W)

Location as "NE/CNWSW" or footage from lines NW-SW-SW  
Lease Owner SHAR ALAN OIL COMPANY  
Lease Name GRIGSBY Well No. 1  
Office Address 1420 DENVER U.S. NAT. CENTER, DENVER, COLO.  
Character of Well (completed as Oil, Gas or Dry Hole) DRY HOLE  
Date well completed JULY 7 19 60  
Application for plugging filed JULY 7 19 60  
Application for plugging approved JULY 7 19 60  
Plugging commenced JULY 7 19 60  
Plugging completed JULY 7 19 60  
Reason for abandonment of well or producing formation DRY

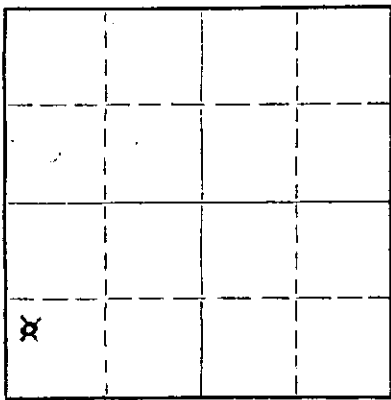

If a producing well is abandoned, date of last production \_\_\_\_\_ 19\_\_\_\_  
Was permission obtained from the Conservation Division or its agents before plugging was commenced? YES

Name of Conservation Agent who supervised plugging of this well FRED HAMPEL, PRETTY PRAIRIE, KANSAS  
Producing formation \_\_\_\_\_ Depth to top \_\_\_\_\_ Bottom \_\_\_\_\_ Total Depth of Well 4663 Feet  
Show depth and thickness of all water, oil and gas formations.

OIL, GAS OR WATER RECORDS

CASING RECORD

FORMATION	CONTENT	FROM	TO	SIZE	PUT IN	PULLED OUT
				<u>3 5/8"</u>	<u>225'</u>	<u>CEMENTED TOP TO BOTTOM</u>

Describe in detail the manner in which the well was plugged, indicating where the mud fluid was placed and the method or methods used in introducing it into the hole. If cement or other plugs were used, state the character of same and depth placed, from \_\_\_\_\_ feet to \_\_\_\_\_ feet for each plug set.

HEAVY MUD TO 220'-WOODEN PLUG @ 220', 1/2 SACK OF HULLS & 15 SACKS OF CEMENT THROUGH DRILL PIPE-MUD TO 35'-WOODEN PLUG, 1/2 SACK OF HULLS & 10 SACKS OF CEMENT-FILLED TO SURFACE-2 SACKS OF CEMENT IN RAT HOLE-CUT SURFACE PIPE BELOW PLOW DEPTH

RECEIVED  
STATE CORPORATION COMMISSION  
JUL 28 1960  
7-28-60  
CONSERVATION DIVISION

(If additional description is necessary, use BACK of this sheet)

Name of Plugging Contractor CLEN DRILLING, INC.  
Address BOX 631, EL DORADO, KANSAS

STATE OF KANSAS, COUNTY OF RUTLER, ss.

I, CLEN GAINES, EMPLOYEE OF OWNER (employee of owner) or (owner or operator) of the above-described well, being first duly sworn on oath, says: That I have knowledge of the facts, statements, and matters herein contained and the log of the above-described well as filed and that the same are true and correct. So help me God.

(Signature) Clen Gaines  
BOX 631, EL DORADO, KANSAS  
(Address)

SUBSCRIBED AND SWORN TO before me this 7th day of JULY, 19 60

My commission expires APRIL 28, 1962

Christiane M. Swilley  
CHRISTIANE K. SWILLEY Notary Public.



15-007-00023-0000  
WELL LOG

COMPANY

SHAR ALAN OIL COMPANY  
1402 DENVER U. S. NATIONAL CENTER  
DENVER 2, COLORADO

LOCATION:  
NW-SW-SW  
SECTION 30-32-11W  
BARBER COUNTY, KANSAS

CONTRACTOR

GLEN DRILLING, INC.  
Box 631  
EL DORADO, KANSAS

FARM

GRIGSBY

DATE COMM

JUNE 17, 1960

DATE COMP

JULY 7, 1960

TOTAL DEPTH

4663' 225' OF 8 5/8" SURFACE CASING - CEMENTED

FROM	TO	
0	50	SAND & GRAVEL
50	107	SHALE & SHELLS
107	225	RED BED
225	315	SHALE & RED BED
315	1050	RED BED & SHALE
1050	1415	SHALE
1415	1993	LIME & SHALE
1993	2090	LIME & SANDY SHALE
2090	2470	SHALE & LIME
2470	2500	SANDY SHALE & LIME
2500	2835	SHALE & LIME
2835	2915	SANDY LIME & SHALE
2915	3040	SHALE & LIME
3040	3058	LIME & SHALE
3058	3224	LIME
3224	3360	SHALE & LIME
3360	3515	SAND & SHALE
3515	3537	SHALE
3537	3580	SAND (DOUGLAS)
3580	3697	SAND & SHALE
3697	3720	LIME (LANSING)
3720	4262	LIME
4262	4295	LIME & SHALE
4295	4315	LIME & CHERT
4315	4367	CHERT
4367	4435	LIME & CHERT
4435	4506	LIME
4506	4540	LIME & SHALE
4540	4605	SHALE & LIME
4605	4624	LIME & CHERT
4624	4663	LIME
4663		TOTAL DEPTH

STATE CONSERVATION COMMISSION

JUL 28 1960

7-28-60  
CONSERVATION DIVISION  
Wichita, Kansas

STATE CONSERVATION COMMISSION

JUL 28 1960

CONSERVATION DIVISION  
Wichita, Kansas

I HEREBY CERTIFY THAT THE FOREGOING IS A TRUE AND CORRECT COPY OF THE WELL LOG FOR THE GRIGSBY # 1 WELL, DRILLED FOR SHAR ALAN OIL COMPANY AND COMPLETED JULY 7, 1960.

GLEN DRILLING, INC.  
*Glen Gaines*  
GLEN GAINES, PRESIDENT

STATE OF KANSAS )SS  
COUNTY OF BUTLER)

SUBSCRIBED AND SWORN TO BEFORE THE UNDERSIGNED, A NOTARY PUBLIC IN AND FOR THE COUNTY AND STATE AFORESAID THE 7TH DAY OF JULY 1960.

*Christiane M. Swilley*  
CHRISTIANE M. SWILLEY, NOTARY PUBLIC

MY COMMISSION EXPIRES APRIL 28, 1962.