


Sent July 13, 1974
15-007-30242-0000

STATE OF KANSAS
STATE CORPORATION COMMISSION

Give All Information Completely
Make Required Affidavit
Mail or Deliver Report to:
Conservation Division
State Corporation Commission

WELL PLUGGING RECORD

P. O. Box 17027
Wichita, Kansas 67217
NORTH

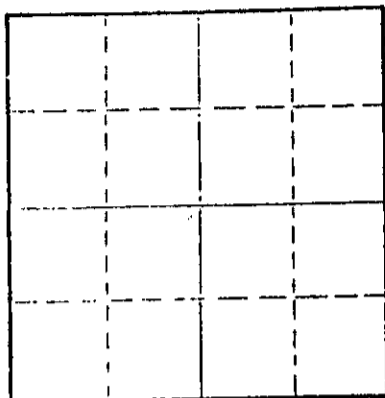

Locate well correctly on above
Section Plat

Barber County, Sec. 30 Twp. 32S Rge. (E) 11 (W)

Location as "NE/CNW&SW" or footage from lines 125' West of C SE SW

Lease Owner Clarke Oilfield Service, Inc.

Lease Name Grigsby Well No. 1

Office Address Box 187, Medicine Lodge, Kansas

Character of Well (completed as Oil, Gas or Dry Hole) Gas

Date well completed July 23, 19 66

Application for plugging filed April 15, 19 74

Application for plugging approved May 16, 19 74

Plugging commenced July 8, 19 74

Plugging completed July 12, 3:00 P.M. 19 74

Reason for abandonment of well or producing formation

Not Productive

If a producing well is abandoned, date of last production Never 19

Was permission obtained from the Conservation Division or its agents before plugging was commenced? Yes

Name of Conservation Agent who supervised plugging of this well Russell Biberstein

Producing formation Douglas Sand Depth to top Bottom Total Depth of Well 3740 Feet

Show depth and thickness of all water, oil and gas formations.

OIL, GAS OR WATER RECORDS

CASING RECORD

FORMATION	CONTENT	FROM	TO	SIZE	PUT IN	PULLED OUT
				8 5/8	204	None
				4 1/2	3738	- 2939

Describe in detail the manner in which the well was plugged, indicating where the mud fluid was placed and the method or methods used in introducing it into the hole. If cement or other plugs were used, state the character of same and depth placed, from feet to feet for each plug set.

Sand From 3740 to 3600.
4 Sacks of Cement From 3600 to 3560.
Ripped pipe at 2939. Pulled and layed down.
Wood Bridge at 200 ft. Rock from 200 to 190.
3 yards of Ready-Mix.

RECEIVED
STATE CORPORATION COMMISSION
JUL 15 1974
7-15-74
CONSERVATION DIVISION
Wichita, Kansas

(If additional description is necessary, use BACK of this sheet)

Name of Plugging Contractor Clarke Corporation
Address Box 187, Medicine Lodge, Kansas 67104

STATE OF Kansas COUNTY OF Barber ss.
Elmer R. Margenstern (employee of owner) or (owner or operator) of the above-described well, being first duly sworn on oath, says: That I have knowledge of the facts, statements, and matters herein contained and the log of the above-described well as filed and that the same are true and correct. So help me God.

(Signature) Elmer R. Margenstern
Medicine Lodge, Kansas
(Address)

SWORN to before me this 13th day of July, 1974.



April 4, 1978
Jodie Hamilton
Notary Public.