


STATE OF KANSAS
STATE CORPORATION COMMISSION

WELL PLUGGING RECORD

Give All Information Completely
Make Required Affidavit
Mail or Deliver Report to:
Conservation Division
State Corporation Commission
P. O. Box 17027
Wichita, Kansas 67217
NORTH

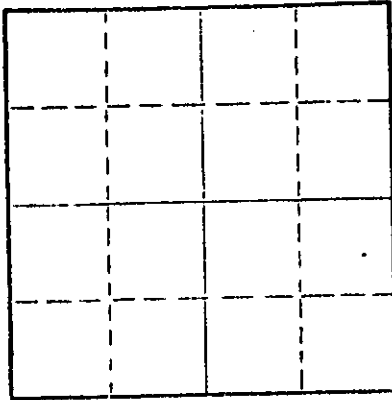

Locate well correctly on above
Section Plat

Harper County, Sec. 8 Twp. 32S Rge. 9 (X) (W)
Location as "NE/CNW/KSW" or footage from lines Approx. C S/2 SW NW
Lease Owner SeRoBee Drlg. & Shaffer Oil Co.
Lease Name Easterby Well No. 1
Office Address 256 North Topeka, Wichita, Kansas 67202
Character of Well (completed as Oil, Gas or Dry Hole) Dry Hole
Date well completed December 11, 1973
Application for plugging filed December 11, 1973
Application for plugging approved December 11, 1973
Plugging commenced December 11, 1973
Plugging completed December 11, 1973
Reason for abandonment of well or producing formation

If a producing well is abandoned, date of last production 19
Was permission obtained from the Conservation Division or its agents before plugging was commenced? Yes

Name of Conservation Agent who supervised plugging of this well G. R. Biberstein
Producing formation Depth to top Bottom Total Depth of Well 4314 Feet
Show depth and thickness of all water, oil and gas formations.

OIL, GAS OR WATER RECORDS

CASING RECORD

FORMATION	CONTENT	FROM	TO	SIZE	PUT IN	PULLED OUT
				8-5/8"	208'	None

Describe in detail the manner in which the well was plugged, indicating where the mud fluid was placed and the method or methods used in introducing it into the hole. If cement or other plugs were used, state the character of same and depth placed, from feet to feet for each plug set.

Mudded up with heavy mud to 200 feet. Followed by wooden plug and 1/2 sack hulls. Placed 25 sacks cement onto hulls. Mudded up with heavy mud to 40 feet followed by wooden plug, 1/2 sack hulls and 10 sacks cement to base of well cellar. Plugged rat hole with 2 sacks cement.

RECEIVED
STATE CORPORATION COMMISSION
DEC 17 1973
12-17-73
CONSERVATION DIVISION
Wichita, Kansas

(If additional description is necessary, use BACK of this sheet)
Name of Plugging Contractor Graves Drilling Co., Inc.
Address 505 Union Center, Wichita, Kansas 67202

STATE OF KANSAS, COUNTY OF SEDGWICK, ss.
John C. Graves (employee of owner) or (owner or operator) of the above-described well, being first duly sworn on oath, says: That I have knowledge of the facts, statements, and matters herein contained and the log of the above-described well as filed and that the same are true and correct. So help me God.

(Signature) John C. Graves
505 Union Center, Wichita, Kansas 67202
(Address)

Subscribed and sworn to before me this 14th day of December, 1973

Betty Brandt
Notary Public.

My commission expires May 9, 1975

ROTARY DRILLERS' LOG

OPERATOR: SeRoBee Drilling Co. DRILLING COMMENCED: December 3, 1973
 & Shaffer Oil Co.
 256 North Topeka
 Wichita, Kansas 67202

CONTRACTOR: Graves Drilling Co., Inc. DRILLING COMPLETED: December 11, 1973
 505 Union Center
 Wichita, Kansas 67202

CASING RECORD: 5 Jts. 208' 8-5/8" LOCATION: Easterby No. 1
 cemented with 215 sacks. Approx. C S/2 SW NW
 Section 8-32S-9W
 Harper County, Kansas

0 - 20 Sod & sand
 20 - 209 Red bed
 209 - 990 Red bed & shale
 990 - 1300 Shale & shells
 1300 - 2050 Shale & lime
 2050 - 3015 Lime & shale
 3015 - 3345 Shale & lime
 3345 - 3493 Lime
 3403 - 3605 Sand & shale
 3605 - 4230 Lime
 4230 - 4302 Lime & shale
 4302 - 4314 Chert
 4314 Totary Total Depth

RECEIVED
 STATE CORPORATION COMMISSION
 DEC 17 1973
 12-17-73
 CONSERVATION DIVISION
 Wichita, Kansas

I hereby certify the foregoing statements to be true and correct to the best of my knowledge.

GRAVES DRILLING CO., INC.

By John Graves President

STATE OF KANSAS)
) ss.
 SEDGWICK COUNTY)

Subscribed and sworn to before me, a Notary Public, this 14th of December, 1973.

Betty Brandt
 Betty Brandt Notary Public

My Commission Expires:

May 9, 1975.