


STATE OF KANSAS
STATE CORPORATION COMMISSION

WELL PLUGGING RECORD

Give All Information Completely
Make Required Affidavit
Mail or Deliver Report to
Conservation Division
State Corporation Comm.
245 North Water
Wichita, KS 67202

Harper County, Sec. 8 Twp. 32 Rge. 9W E/W
Location as "NE/CNW $\frac{1}{4}$ SW $\frac{1}{4}$ " or footage from lines
110' E N/2 SE NE 8-32S-9W
Lease Owner Bryce F. Hayes
Lease Name Kircher Well No. 3
Office Address Box 108, Attica, Kansas 67009
Character of Well (Completed as Oil, Gas or Dry Hole)
Dry Hole
Date Well completed August 19 1982
Application for plugging filed August 19 1982
Application for plugging approved August 19 1982
Plugging commenced August 19 1982
Plugging completed August 19 1982
Reason for abandonment of well or producing formation
Dry Hole
If a producing well is abandoned, date of last production 19

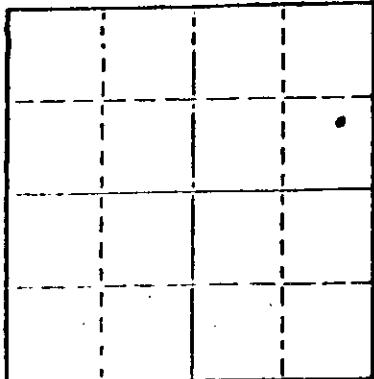

Locate well correctly on above
Section Plot

Name of Conservation Agent who supervised plugging of this well Maurice Leslie
Producing formation _____ Depth to top _____ Bottom _____ Total Depth of Well _____
Show depth and thickness of all water, oil and gas formations.

OIL, GAS OR WATER RECORDS

CASING RECORD

FORMATION	CONTENT	FROM	TO	SIZE	PUT IN	PULLED OUT
Surface Pipe		-0-	265	8 5/8"	265	None

Describe in detail the manner in which the well was plugged, indicating where the mud fluid was placed and the method or methods used in introducing it into the hold. If cement or other plugs were used, state the character of same and depth placed, from _____ feet to _____ feet for each plug set.

Filled hole with heavy mud.

RECEIVED
STATE CORPORATION COMMISSION

#1 Plug set at 650' with 60 sacks cement

9-1-82
SFP 1 1982

#2 Plug set at 250' with 40 sacks cement

CONSERVATION DIVISION
Wichita, Kansas

#3 Plug set at 40' with 10 sacks cement

#4 Plug set in rat hole with 10 sacks cement

(If additional description is necessary, use BACK of this sheet)

Name of Plugging Contractor Sweetman Drilling Inc.

STATE OF Kansas COUNTY OF Harper, ss.
Bryce F. Hayes (employee of owner) or (owner or operator)
of the above-described well, being first duly sworn on oath, says: That I have knowledge of the facts, statements, and matters herein contained and the log of the above-described well as filed and that the same are true and correct. So help me God.

(Signature) Bryce F. Hayes
Box 108, Attica, Kansas 67009
(Address)

SUBSCRIBED AND SWORN TO before me this 31 day of August, 1982

Carol F. Phye
Notary Public.

My commission expires 1-15-1986

CAROL F. PHYE
NOTARY PUBLIC
STATE OF KANSAS
My Appt. Exp. 1-15-86

WELL LOG
Kircher #3
110' E N/2 SE NE 8-32S-9W
Harper County, Kansas

Name of Operator: Bryce F. Hayes
Box 108
Attica, Kansas 67009

Date Plugged: August 19, 1982

<u>FROM</u>	<u>TO</u>	
0	1034	Red Bed
1034	4333	Lime and Shale
4333	4360	Miss.
4360		Total Depth


RECEIVED
STATE CORPORATION COMMISSION

SEP 1 1982
9-1-82
CONSERVATION DIVISION
Wichita, Kansas

STATE OF KANSAS


COUNTY OF BARTON ss

Gary L. Hawk, Secretary of Sweetman Drilling, Inc., being first duly sworn on oath says: That I have knowledge of the facts, statements and matters herein contained and the log of the above described well as filed and that the same are true and correct.

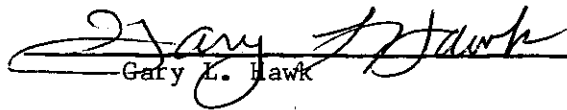

Gary L. Hawk

Subscribed and sworn before me this 24th day of August, 1982.

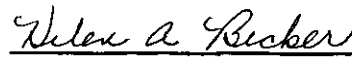

Notary Public Barton County

My Commission expires September 4, 1985.

