


15-007-30274-0000

WELL PLUGGING RECORD

Give All Information Completely
Make Required Affidavit
Mail or Deliver Report to:
Conservation Division
State Corporation Commission
211 No. Broadway
Wichita, Kansas

Barber County, Sec. 29 Twp. 32S Rge. 11W (E) (W)
Location as "NE/CNW/SW" or footage from lines c SE SW
Lease Owner Sioux Petroleum Co., c/o W. F. Roland
Lease Name Zimmerman Well No. 3
Office Address Drawer 270, Medicine Lodge, Kansas 67104
Character of Well (completed as Oil, Gas or Dry Hole) Dry Hole
Date well completed November 24 19 66
Application for plugging filed November 24 19 66
Application for plugging approved November 24 19 66
Plugging commenced November 24 19 66
Plugging completed November 24 19 66
Reason for abandonment of well or producing formation Dry Hole

NORTH

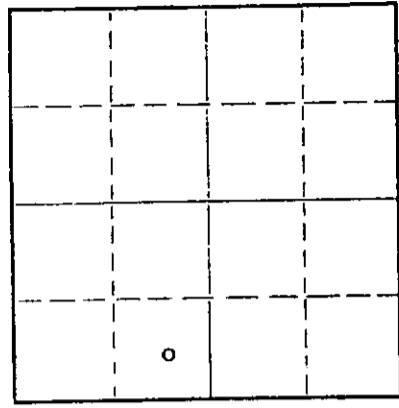

Locate well correctly on above Section Plat

If a producing well is abandoned, date of last production 19
Was permission obtained from the Conservation Division or its agents before plugging was commenced? Yes

Name of Conservation Agent who supervised plugging of this well Archie V. Elving, Pratt, Kansas
Producing formation Depth to top Bottom Total Depth of Well 3800 Feet
Show depth and thickness of all water, oil and gas formations.

OIL, GAS OR WATER RECORDS

CASING RECORD

FORMATION	CONTENT	FROM	TO	SIZE	PUT IN	PULLED OUT
		0	216'	8 5/8"	216'	none

Describe in detail the manner in which the well was plugged, indicating where the mud fluid was placed and the method or methods used in introducing it into the hole. If cement or other plugs were used, state the character of same and depth placed, from feet to feet for each plug set.

Set Plug: 190'/25 sacks cement/1/4 sack hulls
40'/10 sacks cement/1/4 sack hulls
2 sacks cement in rat hole

RECEIVED
STATE CORPORATION COMMISSION
DEC 1 1966
12-1-66
CONSERVATION DIVISION
Wichita, Kansas

(If additional description is necessary, use BACK of this sheet)

Name of Plugging Contractor Hellar Drilling Company, Inc.
Address 1014 Union Center, Wichita, Kansas 67202

STATE OF Kansas COUNTY OF Sedgwick, ss.
D. L. Hellar, President of Hellar Drilling Company, Inc.
(employee of owner) or (owner or operator) of the above-described well, being first duly sworn on oath, says: That I have knowledge of the facts, statements, and matters herein contained and the log of the above-described well as filed and that the same are true and correct. So help me God.

(Signature) D. L. Hellar, President
1014 Union Center, Wichita, Kansas 67202
(Address)

SUBSCRIBED AND SWORN TO before me this 30th day of November, 19 66

My commission expires March 25, 1968

Catherine Darcey
Catherine Darcey - Notary Public.

DRILLER'S LOG

COMPANY: Sioux Petroleum Co., W.F. Roland, Medicine Lodge, Kans
 CONTRACTOR: Hellar Drilling Company, Inc., Wichita, Kansas
 LEASE: #3 Zimmerman
 LOCATION: c SE SW 29-32S-11W, Barber County, Kansas
 COMMENCED: November 17, 1966
 COMPLETED: November 24, 1966
 CASING: Set 8 5/8" surface casing @ 216'/200 sacks cement

0-216	Surface sand & shale
216-580	Shale
580-1100	Shale, Sand, Shells
1100-1653	Salt Section
1653-2014	Ft. Riley
2014-2560	Lime & Shale
2560-3650	Shale & Lime
3650-3800	Lime, Shale & Sand
-3800	Rotary Total Depth
	D & A

RECEIVED
 STATE CORPORATION COMMISSION
 DEC 1 1966
 12-1-66
 REGISTRATION DIVISION
 WICHITA, KANSAS

STATE OF KANSAS)
) SS
 COUNTY OF SEDGWICK)

I, D. L. Hellar, do hereby certify that the above and foregoing is a true and correct copy of the log of the #3 Zimmerman, located in c SE SW Sec. 29-32S-11W, Barber County, Kansas, as reflected by the files of the Hellar Drilling Company, Inc.

HELLAR DRILLING COMPANY, INC.

By *D. L. Hellar*
 President - D. L. Hellar

Subscribed and sworn to before me, a Notary Public, in and for Sedgwick County, Kansas, this 30th day of November, 1966.

Catherine Darcey
 Notary Public - Catherine Darcey

My Commission Expires:
 March 25, 1968.