

STATE OF KANSAS
STATE CORPORATION COMMISSION

Give All Information Completely
Make Required Affidavit
Mail or Deliver Report to:
Conservation Division
State Corporation Commission
211 No. Broadway
Wichita, Kansas

WELL PLUGGING RECORD


Ness County. Sec. 32 Twp. 18 Rge. 21W (E) W (W)

Location as "NE/CNW/SW" or footage from lines C NE NE
Lease Owner Leo J. Dreiling Oil Company
Lease Name Schniepp Well No. 1
Office Address Victoria, Kansas
Character of Well (completed as Oil, Gas or Dry Hole) Oil Well
Date well completed 11-9-1964
Application for plugging filed 8-18-1965
Application for plugging approved 8-18-1965
Plugging commenced 8-18-1965
Plugging completed 8-18-1965
Reason for abandonment of well or producing formation D & A

If a producing well is abandoned, date of last production 7-31-1965
Was permission obtained from the Conservation Division or its agents before plugging was commenced? yes

Name of Conservation Agent who supervised plugging of this well Mr. Eldon Petty-Hays, Kansas
Producing formation 4230 Depth to top _____ Bottom _____ Total Depth of Well 4230 Feet

Show depth and thickness of all water, oil and gas formations.

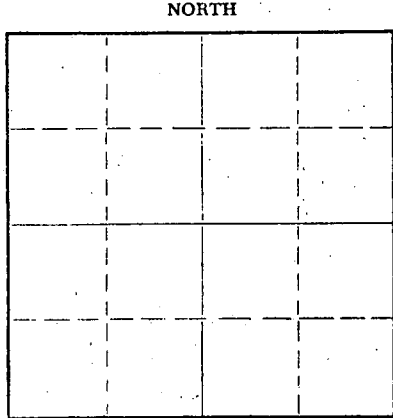

Locate well correctly on above Section Plat.

OIL, GAS OR WATER RECORDS

CASING RECORD

FORMATION	CONTENT	FROM	TO	SIZE	PUT IN	PULLED OUT
301' 8-5/8"	Surface Pipe					

Describe in detail the manner in which the well was plugged, indicating where the mud fluid was placed and the method or methods used in introducing it into the hole. If cement or other plugs were used, state the character of same and depth placed, from _____ feet to _____ feet for each plug set.

Filled with sand from 4227' to 4210' Run 3 sqcks of cement from 4210' to 4190'
Shot 4 1/2" at 3604', 3451', 3297', 3196', & 3097' Worked 35" on tension
Shot 4 1/2" at 2535'. Pulled Pipe. Plugging.
Pumped 75 sacks weight mud & 54 sacks of jel mud at 900'. Pumped 35 sacks of cement at 500'. Pumped 35 sacks of cement at 150'. Pumped 35 sacks of cement to top of cellar.

RECEIVED
STATE CORPORATION COMMISSION

SEP 3 1965

CONSERVATION DIVISION
Wichita, Kansas

(If additional description is necessary, use BACK of this sheet)

Name of Plugging Contractor Glenn & Smith Pipe Pulling Company
Address P.O. Box # 156 Ellinwood, Kansas

STATE OF Kansas, COUNTY OF Ellis, ss.
I, Leo F. Dreiling (employee of owner) ~~owner or operator~~ of the above-described well, being first duly sworn on oath, says: That I have knowledge of the facts, statements, and matters herein contained and the log of the above-described well as filed and that the same are true and correct. So help me God.

(Signature) Leo F. Dreiling
Leo F. Dreiling Victoria, Kansas
(Address)

SUBSCRIBED AND SWORN TO before me this 2nd day of September, 19 65

My commission expires October 26, 1968

Elmer Weltz
Elmer Weltz Notary Public.

L. J. DREILING and SONS, Inc.
VICTORIA, KANSAS

15 135 3056 000

WELL LOG

Company: Leo J. Dreiling Oil Company
Victoria, Kansas

Sec. 32 Twp. 18S Rng. 21 W

Farm: Schniepp No. # 1

Location: C NE NE

Total Depth: 4230'

County: Ness

Comm: 10-30-64 Comp: 11-9-64

Elevation: 2119' D.F.

Contractor: L. J. Dreiling & Sons, Inc.
Victoria, Kansas

2116' G.R.

Casing Record:

Cement Record:

Production:

301' - - - 8-5/8" 225 sacks
4220' - - - 4-1/2" 125 sacks

Figures Indicate Bottom of Formations.

0' - 60'	Shale
60' - 301'	Shale
301' - 551'	Shale
551' - 1233'	Shale & Sand
1233' - 1365'	Shale & Shells
1365' - 1388'	Anhy.
1388' - 1800'	Shale & Shells
1800' - 2136'	Shale & Shells
2136' - 2290'	Lime & Shale
2290' - 2468'	Lime & Shale
2468' - 2578'	Lime & Shale
2578' - 2718'	Lime & Shale
2718' - 2841'	Lime & Shale
2841' - 2960'	Shale & Lime
2960' - 3100'	Shale & Shells
3100' - 3236'	Shale & Lime
3236' - 3417'	Shale & Lime
3417' - 3560'	Lime & Chert
3560' - 3620'	Lime
3620' - 3748'	Lime
3748' - 3818'	Lime
3818' - 3902'	Lime
3902' - 3984'	Lime
3984' - 3994'	Lime
3994' - 4040'	Lime
4040' - 4104'	Lime
4104' - 4138'	Lime
4138' - 4197'	Lime & Shale
4199' - 4230' TD	Lime

RECEIVED
STATE CORPORATION COMMISSION

SEP 3 1965

CONSERVATION DIVISION
Wichita, Kansas

STATE OF KANSAS)
) ss.
COUNTY OF ELLIS)

I, Leo F. Dreiling, of the L. J. Dreiling & Sons, Inc. upon oath states that the above and foregoing is a true and correct copy from the Daily Drilling Report from your Schniepp # 1.

Leo F. Dreiling
LEO F. DREILING

Subscribed and sworn to before me this 24th day of November, 1964.

Elmer J. Kelly
NOTARY PUBLIC

My Commission Expires: October, 26, 1968