


STATE OF KANSAS
STATE CORPORATION COMMISSION

Give All Information Completely
Make Required Affidavit
Mail or Deliver Report to:
Conservation Division
State Corporation Commission
P. O. Box 17027
Wichita, Kansas 67217
NORTH

WELL PLUGGING RECORD

Barber County. Sec. 14 Twp. 32 Rge. 15 (E) W (W)
Location as "NE/CNW/SW" or footage from lines C SE SW
Lease Owner Walters Drilling Co.
Lease Name Swayden Well No. # 2
Office Address 400 Ins. Bldg. ; Wichita, Ks. 67202
Character of Well (completed as Oil, Gas or Dry Hole) Oil
Date well completed June 22 1965
Application for plugging filed December 4 1972
Application for plugging approved December 5 1972
Plugging commenced December 19 1972
Plugging completed December 23 1972
Reason for abandonment of well or producing formation Oil production depleted
If a producing well is abandoned, date of last production August 13 1972
Was permission obtained from the Conservation Division or its agents before plugging was commenced? Yes

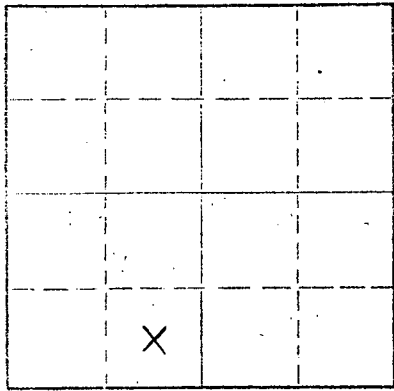

Locate well correctly on above Section Plat

Name of Conservation Agent who supervised plugging of this well Russell Biberstein
Producing formation Viola Depth to top _____ Bottom _____ Total Depth of Well 5030 Feet
Show depth and thickness of all water, oil and gas formations.

OIL, GAS OR WATER RECORDS				CASING RECORD		
FORMATION	CONTENT	FROM	TO	SIZE	PUT IN	PULLED OUT
				8 5/8"	275	None
				5 1/2"	5026	3804

Describe in detail the manner in which the well was plugged, indicating where the mud fluid was placed and the method or methods used in introducing it into the hole. If cement or other plugs were used, state the character of same and depth placed, from _____ feet to _____ feet for each plug set.


December 19, 1972 Plugged off bottom. Dumped sand to 4900'. Mixed and dumped 5 sx of cement.
December 23, 1972 Plugged off top. Set 10' rock bridge at 360'. Filled hole and casing from 360' to base of cellar with 3000 lb. ready-mix concrete.

RECEIVED
STATE CORPORATION COMMISSION
JAN 10 1973
1-10-73
CONSERVATION DIVISION
Wichita, Kansas

(If additional description is necessary, use BACK of this sheet)
Name of Plugging Contractor RUSS CASING PULLING, INC.
Address P. O. Box 1082 ; Great Bend, Kansas 67530

STATE OF KANSAS COUNTY OF SEDGWICK, ss.
Robert F. Walters, Mng. Part., Walters Drilling Co. (employee of owner) or (owner or operator) of the above-described well, being first duly sworn on oath, says: That I have knowledge of the facts, statements, and matters herein contained and the log of the above-described well as filed and that the same are true and correct. So help me God.

(Signature) Robert F. Walters
Robert F. Walters
400 Insurance Building, Wichita, Kansas 67202 (Address)
Subscribed and sworn to before me this 8th day of January, 1973
Ruth Every
Ruth Every Notary Public.
My commission expires June 10, 1973

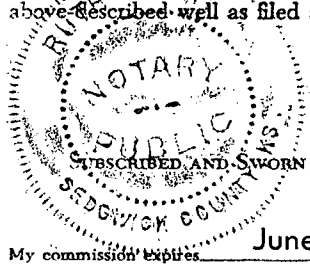

DRILLER'S LOG

COMPANY: FERGUSON OIL COMPANY ET AL
1505 WICHITA PLAZA BUILDING
WICHITA, KANSAS

WELL NAME: SWAYDEN #2
C SE SW SECTION 14-32S-15W
BARBER COUNTY, KANSAS

CONTRACTOR: WALTERS DRILLING CO.
510 ORPHEUM BUILDING
WICHITA, KANSAS

ROTARY DRILLING COMMENCED: JUNE 8, 1965
ROTARY DRILLING COMPLETED: JUNE 22, 1965

ELEVATION: 1996 KB

CASING RECORD: 8 5/8" set @ 275' w/ 200 sacks

LOG


0 - 310	Soil, Red Bed, Shale
310 - 340	Sand
340 - 880	Shale and Red Bed
880 - 1340	Shale
1340 - 1900	Shale and Shells
1900 - 2195	Shale - L. Streaks
2195 - 2406	Lime
2406 - 2550	Lime and Shale
2550 - 2640	Lime
2640 - 2785	Lime and Shale
2785 - 2900	Lime
2900 - 3115	Shale and Sand
3115 - 3360	Shale and Lime
3360 - 3482	Shale and L. Streaks
3482 - 3630	Shale and Cky. Lime
3630 - 4205	Shale and Lime
4205 - 4390	Lime and Shale
4390 - 4920	Lime
4920 - 4958	Lime and Shale
4958 - 4968	Core #1
4968 - 4972	Core #2
4972 - 4981 ¹ / ₂	Core #3
4981 - 5030	Lime
<u>5030</u>	<u>Rotary Total Depth</u>

RECEIVED
STATE CORPORATION COMMISSION
DEC 6 - 1972
12-6-72
CONSERVATION DIVISION
Wichita, Kansas


The undersigned, Robert F. Walters, hereby certifies, in behalf of said company that the above log is a true and correct log of the formations encountered in drilling the above well as reflected by the Daily Drilling Reports.

WALTERS DRILLING CO.

BY

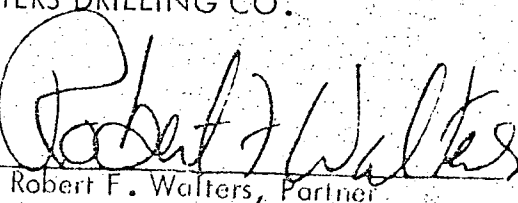
Robert F. Walters, Partner

Subscribed and sworn to before me
this 5th day of July, 1965.


Juanita M. Green, Notary Public

My Commission Expires: October 4, 1967