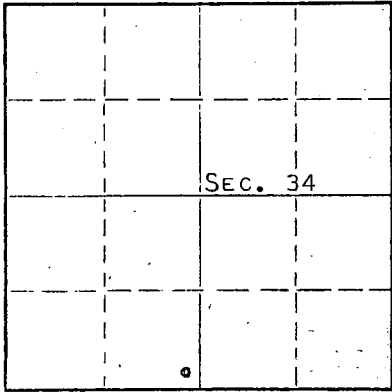


STATE OF KANSAS
STATE CORPORATION COMMISSIONGive All Information Completely
Make Required Affidavit
Mail or Deliver Report to:
Conservation Division
State Corporation Commission
111 No. Broadway
Wichita, Kansas

WELL PLUGGING RECORD

NORTH

Locate well correctly on above
Section Plat

BARBER County. Sec. 34 Twp. 32S Rge. 11W (X) X(W)
Location as "NE/CNW/SW" or footage from lines SE SE SW
Lease Owner PETROLEUM, INC.
Lease Name WILLIAMS "C" Well No. 1
Office Address ROUTE 2, GREAT BEND, KANSAS
Character of Well (completed as Oil, Gas or Dry Hole) GAS
Date well completed DECEMBER 22, 1956
Application for plugging filed APRIL 11, 1962
Application for plugging approved APRIL 12, 1962
Plugging commenced APRIL 13, 1962
Plugging completed APRIL 19, 1962
Reason for abandonment of well or producing formation DEPLETION OF PRODUCIBLE FORMATIONS.

If a producing well is abandoned, date of last production SEPTEMBER 6, 1961
Was permission obtained from the Conservation Division or its agents before plugging was commenced? YES

Name of Conservation Agent who supervised plugging of this well FRED W. HAMPEL
Producing formation DOUGLAS SAND Depth to top 3724 Bottom Total Depth of Well 4572 Feet
Show depth and thickness of all water, oil and gas formations.

OIL, GAS OR WATER RECORDS

CASING RECORD

FORMATION	CONTENT	FROM	TO	SIZE	PUT IN	PULLED OUT
DOUGLAS SAND	WATER & LITTLE GAS	3729 1/2'	3734'	8-5/8"	223'	NONE
				4-1/2"	4567'	2930'

Describe in detail the manner in which the well was plugged, indicating where the mud fluid was placed and the method or methods used in introducing it into the hole. If cement or other plugs were used, state the character of same and depth placed, from feet to feet for each plug set.

PLUGGED BACK T.D. 3743'

FILLED HOLE WITH CRUSHED ROCK FROM 3743' TO 3680', PLACED 4 SACKS CEMENT ONTO CRUSHED ROCK. MUDDIED UP WITH HEAVY MUD TO 210' AND BUILD ROCK BRIDGE. FILLED HOLE WITH CONCRETE TO BASE OF WELL CELLAR.

RECEIVED
STATE CORPORATION COMMISSIONAPR 23 1962
4-23-62
CONSERVATION DIVISION
Wichita, Kansas

(If additional description is necessary, use BACK of this sheet)

Name of Plugging Contractor GARVEY DRILLING COMPANY
Address ROUTE 2, GREAT BEND, KANSAS

STATE OF KANSAS, COUNTY OF BARTON, ss.
DON SEARLE

(employee of owner) or (owner or operator) of the above-described well, being first duly sworn on oath, says: That I have knowledge of the facts, statements, and matters herein contained and the log of the above-described well as filed and that the same are true and correct. So help me God. DON SEARLE, DIST. PROD. SUPT.

(Signature)

ROUTE 2, GREAT BEND, KANSAS
(Address)

SUBSCRIBED AND SWORN TO before me this 20TH day of APRIL, 1962

My commission expires APRIL 14, 1963

Notary Public

15-007-00355-0000
WELL LOG

COMPANY PETROLEUM, INCORPORATED

SEC. 34 T. 32S R. 11W

FARM Williams 'C' NO. 1

LOC. SE, SE, SW


TOTAL DEPTH 4572'

COUNTY Barber Co., Kansas

COMM. November 17, 1956 COMP. December 2, 1956

CONTRACTOR GARVEY DRILLING COMPANY

CASING 8 5/8" @ 223' W/175 s ax.
4 1/2" @ 4567' W/150 sax.

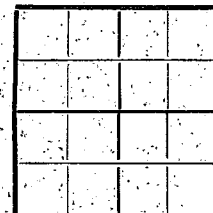

ELEVATION 1521' DF

PRODUCTION Douglas

FIGURES INDICATE BOTTOM OF FORMATIONS

60	Red bed
223	Red bed & shale
820	Red bed & Red shale
1160	Shale & shells
1295	Shale
1335	Salt & shale
1355	Anhydrite
1645	Shale & shells
2300	Lime
2465	Lime & shale
3020	Shale & shells
3140	Lime
3247	Lime & shale
3350	Shale & shells
3768	Shale
3870	Sand & shale
3898	Lime & shale
4283	Lime
4430	Shale & lime
4472	Lime & chert
4488	Chert
4490	Lime
4497	Lime & chert
4540	Chert & shale
4572	Lime
4572	T. D.

RECEIVED
STATE CORPORATION COMMISSION
APR 23 1962
4-23-62
CONSERVATION DIVISION
Wichita, Kansas

State of KANSAS

County of BARTON

SS:

I, Verne A. Morris of Garvey Drilling Co.

upon oath state that the above and foregoing is a true and correct copy of the log of the #1 Williams 'C' well

Subscribed and sworn to before me this 26th day of December 1956

My Commission Expires: July 11, 1960

Verne A. Morris
Red T. Brown
NOTARY PUBLIC