


STATE OF KANSAS
STATE CORPORATION COMMISSION

Form CP-4

Give All Information Completely.
Make Required Affidavit
Mail or Deliver Report to:
Conservation Division
State Corporation Commission
212 No. Market
Wichita, Kansas 67202

WELL PLUGGING RECORD

Barber County, Sec. 33 Twp. 32 Rge. (E) 11 (W)
Location as "NE/CNWSW" or footage from lines NE NE NE
Lease Owner A. Ainsworth
Lease Name Lenkner Well No. 1
Office Address
Character of Well (completed as Oil, Gas or Dry Hole) Oil
Date well completed March 18, 1972
Application for plugging filed 19
Application for plugging approved 19
Plugging commenced March 18, 1972
Plugging completed 3:30 P.M. March 23, 1972
Reason for abandonment of well or producing formation
Hole full of water
If a producing well is abandoned, date of last production None 19
Was permission obtained from the Conservation Division or its agents before plugging was commenced? Yes

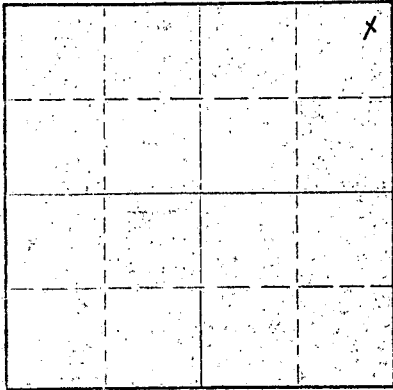

Locate well correctly on above
Section Plat

Name of Conservation Agent who supervised plugging of this well Russell Bieberstein
Producing formation Depth to top Bottom Total Depth of Well 4750 Feet
Show depth and thickness of all water, oil and gas formations.

OIL, GAS OR WATER RECORDS

CASING RECORD


FORMATION	CONTENT	FROM	TO	SIZE	PUT IN	PULLED OUT
				8 5/8	316	None
				5 1/2	4794	1800

Describe in detail the manner in which the well was plugged, indicating where the mud fluid was placed and the method or methods used in introducing it into the hole. If cement or other plugs were used, state the character of same and depth placed, from feet to feet for each plug set.

Sand to 4322
5 sacks cement 4322 to 4287

Ripped pipe at 3600, 3400, 3200, 2800, 2600, 2400, 2100, 1800. Pulled 5 1/2".
Had spotted oil after ripping pipe at 3600. Could not move pipe.

Built wood bridge at 270. Rock from 270 to 260. Then dumped 4 1/2 yards of Ready mix Cement to bottom of cellar.

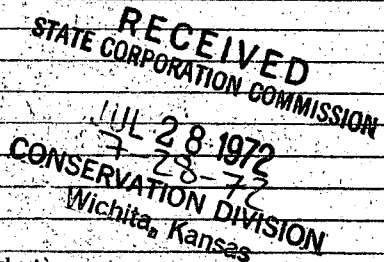

(If additional description is necessary, use BACK of this sheet)

Name of Plugging Contractor CLARKE CORPORATION
Address 107 West Fowler, Medicine Lodge, Kansas. 67104

STATE OF KANSAS COUNTY OF BARBER ss.
Elmo R. Morgenstern (Foreman) (employee of owner) or (owner or operator) of the above-described well, being first duly sworn on oath, says: That I have knowledge of the facts, statements, and matters herein contained and the log of the above-described well as filed and that the same are true and correct. So help me God.

(Signature) Elmo R. Morgenstern
Medicine Lodge, Kansas 67104
(Address)

SUBSCRIBED AND SWORN to before me this 1st day of April, 1972

My commission expires April 4, 1974

Notary Public.