

15-077-0001-0000

STATE OF KANSAS
STATE CORPORATION COMMISSION

WELL PLUGGING RECORD

Give All Information Completely
Make Required Affidavit
Mail or Deliver Report to:
Conservation Division
State Corporation Commission
800 Bitting Building
Wichita, Kansas

Harper County, Sec. 11 Twp. 32s Rge. 9w (E) (W)

Location as "NE/CNW/SW" or footage from lines CNL SW/4 SW/4

Lease Owner Mull Drilling Co., Inc.

Lease Name Eva Biberstein Well No. 1

Office Address 670 N Fourth National Bank Bldg. Wichita, Kansas

Character of Well (completed as Oil, Gas or Dry Hole) Dry Hole

Date well completed 10-11- 19 59

Application for plugging filed 10-11 19 59

Application for plugging approved 10-11 19 59


Plugging commenced 7:00 A. M. 10-11 19 59

Plugging completed 9:00 A. M. 10-11- 19 59

Reason for abandonment of well or producing formation No production

If a producing well is abandoned, date of last production none 19

Was permission obtained from the Conservation Division or its agents before plugging was commenced? yes

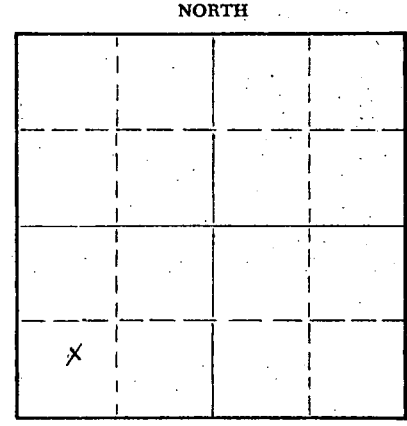

Locate well correctly on above Section Plat

Name of Conservation Agent who supervised plugging of this well Fred Hampel Pretty Prairie, Kansas

Producing formation Depth to top Bottom Total Depth of Well 4440 Feet

Show depth and thickness of all water, oil and gas formations.

OIL, GAS OR WATER RECORDS

CASING RECORD

FORMATION	CONTENT	FROM	TO	SIZE	PUT IN	PULLED OUT

Describe in detail the manner in which the well was plugged, indicating where the mud fluid was placed and the method or methods used in introducing it into the hole. If cement or other plugs were used, state the character of same and depth placed, from feet to feet for each plug set.

Hole filled within 200' of top with drilling mud. #1 plug pushed to this depth and 1/2 sack hulls added 18 sacks cement put on top through drill pipe. Hole filled with fluid to within 30' of top. #2 plug pushed to this depth and tied. 1/2 sack hulls added on top of plug. 10 sacks cement put on top of plug. This completed hole plugging. 2 sacks cement put in rat hole to plug.

RECEIVED
STATE CORPORATION COMMISSION

OCT 19 1959

10-19-59
CONSERVATION DIVISION

(If additional description is necessary, use BACK of this sheet)

Name of Plugging Contractor Company tools
Address

STATE OF KANSAS, COUNTY OF SEDGWICK, ss. Joseph O. Butts

(employee of owner) or (owner or operator) of the above-described well, being first duly sworn on oath, says: That I have knowledge of the facts, statements, and matters herein contained and the log of the above-described well as filed and that the same are true and correct. So help me God.

(Signature) Joseph O. Butts
(Address)

SUBSCRIBED AND SWORN TO before me this 15th day of October, 1959

My commission expires January 28, 1961

Ethel Zimmerman
Ethel Zimmerman Notary Public.



