


STATE OF KANSAS
STATE CORPORATION COMMISSION

Form CP-4

Give All Information Completely
Make Required Affidavit
Mail or Deliver Report to:
Conservation Division
State Corporation Commission
P. O. Box 17027
Wichita, Kansas 67217
NORTH

WELL PLUGGING RECORD

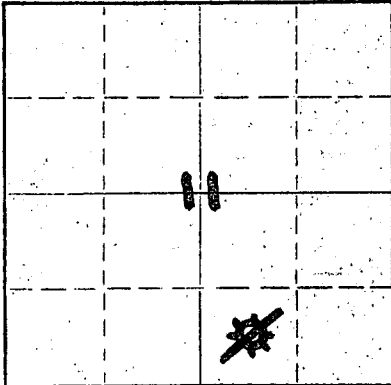

Locate well correctly on above
Section Plat

Harper County. Sec. 11 Twp. 32 Rge. (E) 9 (W)
Location as "NE/CNW/SW" or footage from lines C - SW - SE
Lease Owner Hershberger Explorations, Inc.
Lease Name Archibald Well No. 1
Office Address 200 West Douglas, Suite 230, Wichita, Kansas 67202
Character of Well (completed as Oil, Gas or Dry Hole) Gas well
Date well completed 7 - 3 1972
Application for plugging filed 10 - 25 1972
Application for plugging approved 10 - 26 1972
Plugging commenced 10 - 30 1972
Plugging completed 11 - 6 1972
Reason for abandonment of well or producing formation Gas volume declined -
Non commercial
If a producing well is abandoned, date of last production No runs 19
Was permission obtained from the Conservation Division or its agents before plugging was commenced? Yes

Name of Conservation Agent who supervised plugging of this well Russell Biberstein
Producing formation Mississippian Depth to top 4415 Bottom --- Total Depth of Well 4430 Feet
Show depth and thickness of all water, oil and gas formations.

OIL, GAS OR WATER RECORDS

CASING RECORD

FORMATION	CONTENT	FROM	TO	SIZE	PUT IN	PULLED OUT
Mississippian	Gas, Water	4415	4430	8 5/8	230	None
		T. D. in		4 1/2	4417	3328.17
		Mississippian				

Describe in detail the manner in which the well was plugged, indicating where the mud fluid was placed and the method or methods used in introducing it into the hole. If cement or other plugs were used, state the character of same and depth placed, from _____ feet to _____ feet for each plug set.

Dumped sand From 4430 to 4400

Dumped 3 sacks cement From 4400 to 4370

Ripped pipe at 3800, 3500 and 3328.

Pulled 4 1/2" casing. Layed down.

Built rock bridge from 320 to 310.

Then dumped 5 yards of Ready Mix cement.

Cement to top of surface.

RECEIVED
STATE CORPORATION COMMISSION
NOV 13 1972
11-13-72
CONSERVATION DIVISION
Wichita, Kansas

(If additional description is necessary, use BACK of this sheet)

Name of Plugging Contractor Clarke Corporation
Address Box 187, Medicine Lodge, Kansas 67104

STATE OF Kansas, COUNTY OF Sedgwick, ss.
William A. Sladek, III

(employee of owner) or (owner or operator) of the above-described well, being first duly sworn on oath, says: That I have knowledge of the facts, statements, and matters herein contained and the log of the above-described well as filed and that the same are true and correct. So help me God.

(Signature) William A. Sladek

Suite 230, 200 W. Douglas, Wichita, Kans.

(Address)

SUBSCRIBED AND SWORN TO before me this 10th day of November, 1972

My commission expires September 9, 1976

Bernice Pendleton Notary Public

ORIGINAL NOT AVAILABLE
15-077-20149-0000

DRILLERS LOG

ARCHIBALD NO. 1

CASING RECORD:	OPERATOR: Hershberger Explorations	DESCRIPTION:
8-5/8" @ 232'	CONTRACTOR: Sage Drilling Co.	Ap C SW SE
w/130 sax cement	COMMENCED: May 27, 1972	Sec. 11-32S-9W
TOTAL DEPTH:	COMPLETED: June 4, 1972	Harper Co., Kans.
4430'		ELEVATION: 1534KB


<u>FORMATION</u>	<u>FROM</u>	<u>TO</u>	<u>REMARKS</u>
Surface Soil	0	350	
Shale	350	1140	
Shale w/Lime Streaks	1140	1380	
Lime & Shale	1380	3330	
Shale & Lime	3330	3610	
Lime & Shale	3610	3738	
Sand	3738	3810	
Lime	3810	4133	
Lime & Shale	4133	4190	
Lime	4190	4260	
Lime & Shale	4260	4395	
Lime	4395	4415	
Chert	4415	4430	4 1/2" set @ 4417' w/100 sax cement

RECEIVED
STATE CORPORATION COMMISSION
JAN 18 1973
1-18-73
CONSERVATION DIVISION
Wichita, Kansas

I certify that this is a true and correct copy of the above log to the best of my knowledge.

SAGE DRILLING CO., INC.

By Clarence Michael
Clarence Michael

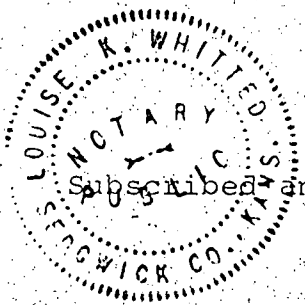

Subscribed and sworn to before me this 6th day of June, 1972.

Louise K. Whitted
Louise K. Whitted, Notary Public

My commission expires:
November 26, 1974.