


STATE OF KANSAS
STATE CORPORATION COMMISSION

Give All Information Completely
Make Required Affidavit
Mail or Deliver Report to:
Conservation Division
State Corporation Commission
800 Biting Building
Wichita, Kansas

WELL PLUGGING RECORD

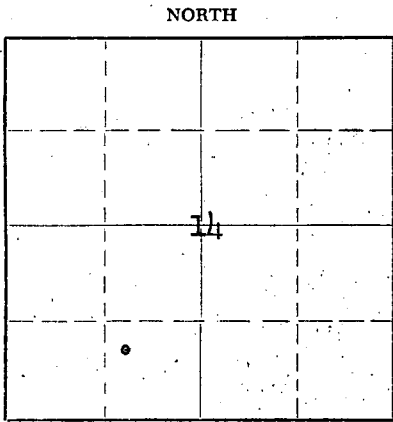

Barber County, Sec. 14 Twp. 32S Rge. (E) 13(W)
Location as "NE/CNW/SW" or footage from lines Ctr. SW/4 SE/4 SW/4
Lease Owner Monsanto Chemical Company (Lion Oil Company Division)
Lease Name Brooks & Younger Well No. 4
Office Address P. O. Box 580, Pratt, Kansas
Character of Well (completed as Oil, Gas or Dry Hole) Dry Hole
Date well completed August 2, 1956
Application for plugging filed August 2, 1956
Application for plugging approved (Verbal) August 2, 1956
Plugging commenced August 2, 1956
Plugging completed August 2, 1956
Reason for abandonment of well or producing formation Dry Hole

Locate well correctly on above Section Plat

If a producing well is abandoned, date of last production 19
Was permission obtained from the Conservation Division or its agents before plugging was commenced? Yes

Name of Conservation Agent who supervised plugging of this well Mr. Merle Rives
Producing formation None Depth to top _____ Bottom _____ Total Depth of Well 4505 Feet
Show depth and thickness of all water, oil and gas formations.

OIL, GAS OR WATER RECORDS

CASING RECORD

FORMATION	CONTENT	FROM	TO	SIZE	PUT IN	PULLED OUT
				8-5/8"	350'	None

Describe in detail the manner in which the well was plugged, indicating where the mud fluid was placed and the method or methods used in introducing it into the hole. If cement or other plugs were used, state the character of same and depth placed, from _____ feet to _____ feet for each plug set.

Plugged with Heavy Mud from 4505' to 320', Halliburton Plug at 320' with 1/4 sack of hulls and 20 sacks of cement on top of plug. Heavy Mud to 35' and Halliburton Plug at 35' with 1/4 sack of hulls and 10 sacks of cement on top of plug. Cement to base of cellar.

(If additional description is necessary, use BACK of this sheet)

Name of Plugging Contractor Garvey Drilling Company
Address 311 East Third St., Wichita, Kansas

STATE OF KANSAS, COUNTY OF PRATT, ss.
J. B. Gibbs (employee of owner) or (owner or operator) of the above-described well, being first duly sworn on-oath, says: That I have knowledge of the facts, statements, and matters herein contained and the log of the above-described well as filed and that the same are true and correct. So help me God.

(Signature) [Signature]
P. O. Box 580, Pratt, Kansas.
(Address)

SUBSCRIBED AND SWORN TO before me this 3rd day of August, 1956

Merle F. Lamb
Notary Public.

My commission expires September 19, 1959

RECEIVED
STATE CORPORATION COMMISSION
AUG 19 1956
080456
CONS. DIVISION
WICHITA, KANSAS

PLUGGING
FILE SEC. 14 T. 32 R. 13W
BOOK PAGE 87 LINE 15

WELL LOG

COMPANY LION OIL COMPANY

SEC. 14 T. 32S R. 13W

FARM Brooks-Younger NO. 4


LOC. SW, SE, SW

TOTAL DEPTH 4505'

COUNTY Barber Co., Kansas

COMM. July 17, 1956 COMP. August 2, 1956

CONTRACTOR GARVEY DRILLING COMPANY

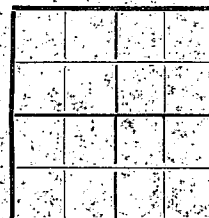

CASING 8 5/8" @ 342' W/175 sax.

ELEVATION 1664' DF

PRODUCTION D & A

FIGURES INDICATE BOTTOM OF FORMATIONS!

185	Surface clay
900	Red bed
1300	Shale & shells
1625	Lime & shale
2500	Lime
3000	Lime & shale
3110	Lime
3355	Lime & shale
3515	Lime
3703	Lime & shale
4406	Lime
4437	Lime & chert
4481	Chert
4505	Shale & lime
4505	T. D.

RECEIVED
 STATE COMMISSION
 SEP 7 1956
 CONSERVATION DIVISION
 Topeka, Kas.

State of KANSAS
 County of BARTON

PLUGGING
 FILE SEC 14 T. 32 R. 13W
 BOOK PAGE 87 LINE 15

I, Verne A. Morris of Garvey Drilling Co.

upon oath state that the above and foregoing is a true and correct copy of the log of the #1 Brooks-Younger well

Verne A. Morris

Subscribed and sworn to before me this 8th day of August 19 56

My Commission Expires: July 11, 1960

Jed J. Brown
 NOTARY PUBLIC