

STATE OF KANSAS
STATE CORPORATION COMMISSION

Give All Information Completely
Make Required Affidavit
Mail or Deliver Report to:
Conservation Division
State Corporation Commission
211 No. Broadway
Wichita, Kansas

WELL PLUGGING RECORD

Barber County, Sec. 17 Twp. 32 Rge. 13 (E) (W) X

Location as "NE/CNW%SW%" or footage from lines SW SE SW

Lease Owner Raymond Oil Company, Inc.

Lease Name Tedrow Well No. #1

Office Address 110 Fourth National Bank Bldg., Wichita 2, Kansas

Character of Well (completed as Oil, Gas or Dry Hole)

Date well completed 19

Application for plugging filed 5-8-62 19

Application for plugging approved 5-9-62 19


Plugging commenced 6-10-62 19

Plugging completed 6-13-62 19

Reason for abandonment of well or producing formation

If a producing well is abandoned, date of last production 19

Was permission obtained from the Conservation Division or its agents before plugging was commenced?

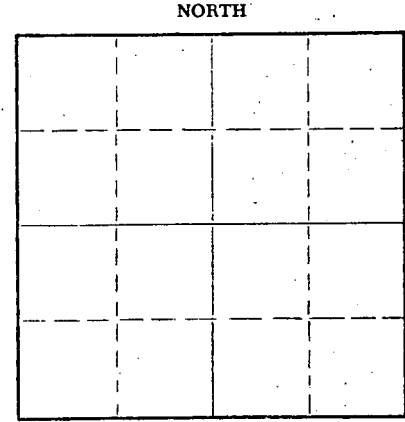

Locate well correctly on above Section Plat

Name of Conservation Agent who supervised plugging of this well Fred Hempel LACKAMP

Producing formation Depth to top Bottom Total Depth of Well 4590 Feet

Show depth and thickness of all water, oil and gas formations.

OIL, GAS OR WATER RECORDS

CASING RECORD

FORMATION	CONTENT	FROM	TO	SIZE	PUT IN	PULLED OUT

Describe in detail the manner in which the well was plugged, indicating where the mud fluid was placed and the method or methods used in introducing it into the hole. If cement or other plugs were used, state the character of same and depth placed, from feet to feet for each plug set.

Sanded back to 4570' - mixed and dumped 5 sacks cement with dump bailor.

Mudded hole to 200' - set rock bridge - mixed and dumped 20 sacks cement.

Mudded hole to 30' - set rock bridge - mixed and dumped 10 sacks cement for top cap.

RECEIVED
STATE CORPORATION COMMISSION

JUN 15 1962

CONSERVATION DIVISION
Wichita, Kansas

(If additional description is necessary, use BACK of this sheet)

Name of Plugging Contractor Southwest Casing Pulling Co., Inc.

Address Box 364, Great Bend, Kansas

STATE OF Kansas, COUNTY OF Barton, ss.

Southwest Casing Pulling Co., Inc. (employee of owner) or (owner or operator) of the above-described well, being first duly sworn on oath, says: That I have knowledge of the facts, statements, and matters herein contained and the log of the above-described well as filed and that the same are true and correct. So help me God.

(Signature) W. C. Spencer Sec.

Box 364, Great Bend, Kansas (Address)

SUBSCRIBED AND SWORN TO before me this 14 day of June, 19 62

My commission expires 24 October 1964

Sidney D. Miller Notary Public.



RAYMOND OIL COMPANY, INC. #1 TEDROW
 SW SE SW 17-32S-13W
 Barber County, Kansas

ELEVATION: 1841 D.F.
 1844 K.B.

Contractor: Company Tools - Rig No. 3
 Commenced: October 7, 1961
 Completed: October 22, 1961 (Rotary)

Casing Record:
 8 5/8" @ 302'
 5 1/2" @ 4589'

Figures Indicate Bottom of Formation

<u>Formation</u>	<u>Depth</u>
Red Bed and Sand	302
Red Bed	340
Red Bed and Shale	1122
Red Bed and Shale with Lime Streaks	1870
Shale and Lime	2175
Lime and Shale	2319
Lime	2425
Broken Lime	2500
Lime and Shale	2595
Lime	2730
Shale and Lime	3500
Lime and Shale	3720
Shale & Lime	3835
Lime and Shale	3910
Shale	3924
Shale and Lime	4000
Lime	4080
Lime with Shale	4120
Lime	4149
Lime and Shale	4190
Lime	4280
Lime with Shale	4329
Lime	4590 RTD
<u>TOPS</u>	
Heebner	3869
Douglas	3913
Lansing-Kansas City	4047
Base Kansas City	4461
Marmaton	4472
Massey Zone	4496
Mississippi	4550
Rotary Total Depth	4590

RECEIVED
 STATE CORPORATION COMMISSION
 MAY 9 1962
 CONSERVATION DIVISION
 Wichita, Kansas


STATE OF KANSAS)
) SS.
 COUNTY OF SEDGWICK)

I hereby certify that the above is true and correct to the best of my knowledge.

Rick P. Clinton
 Rick P. Clinton, Executive Vice President

Subscribed and sworn to before me this 27th day of October, 1961.

Bernice Boldt
 Notary Public

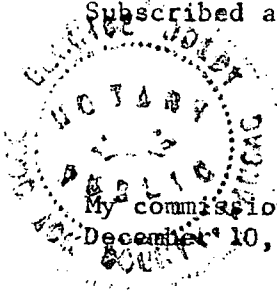

My commission expires
 December 10, 1962