


STATE OF KANSAS
STATE CORPORATION COMMISSION

Give All Information Completely
Make Required Affidavit
Mail or Deliver Report to:
Conservation Division
State Corporation Commission
800 Bitting Building
Wichita, Kansas

15-007-01040-0000
WELL PLUGGING RECORD

Barber County. Sec. 6 Twp. 34S Rge. (E) 13 (W)
Location as "NE/CNW $\frac{1}{4}$ SW $\frac{1}{4}$ " or footage from lines NW NW NE
Lease Owner K & E DRILLING, INC.
Lease Name OTT Well No. 1
Office Address 1006 Central Building, Wichita, Kansas
Character of Well (completed as Oil, Gas or Dry Hole) Dry Hole
Date well completed March 17 19 52
Application for plugging filed March 17 19 52
Application for plugging approved March 17 19 52
Plugging commenced March 17 19 52
Plugging completed March 17 19 52
Reason for abandonment of well or producing formation Commercial quantity of oil not found
If a producing well is abandoned, date of last production 19
Was permission obtained from the Conservation Division or its agents before plugging was commenced? Yes

NORTH

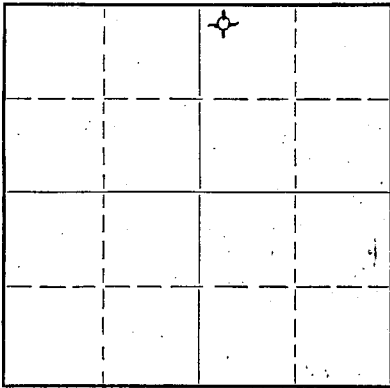

Locate well correctly on above Section Plat

Name of Conservation Agent who supervised plugging of this well M. A. Rives
Producing formation Depth to top Bottom Total Depth of Well 5502 Feet
Show depth and thickness of all water, oil and gas formations.

OIL, GAS OR WATER RECORDS

CASING RECORD

Formation	Content	From	To	Size	Put In	Pulled Out
				8 5/8	352	None

Describe in detail the manner in which the well was plugged, indicating where the mud fluid was placed and the method or methods used in introducing it into the hole. If cement or other plugs were used, state the character of same and depth placed, from feet to feet for each plug set.

Filled hole with heavy mud to 350'. Set plug at 350' topped with 15 sacks cement. Filled to 35' with heavy mud. Set second plug at 35'. Capped with 10 sacks cement.

03-27-52
03-27-52

(If additional description is necessary, use BACK of this sheet)
Name of Plugging Contractor Deek Drilling, Inc.
Address Central Building, Wichita, Kansas

STATE OF KANSAS, COUNTY OF SEDGWICK, ss.
Clinton Engstrand, agent for (employee of owner) (owner or operator) of the above-described well,
being first duly sworn on oath, says: That I have knowledge of the facts, statements, and matters herein contained and the log of the above-described well as filed and that the same are true and correct. So help me God.

(Signature) *Clinton Engstrand*
Central Building, Wichita, Kansas
(Address)

SUBSCRIBED AND SWORN to before me this 25th day of March, 19 52

Due Paul
Notary Public.

My commission expires 12-19-55

23-8390-5 6-51-20M
PLUGGING
FILE SEC 6 T 34 R 13
BOOK PAGE 2 LINE 36

K & E DRILLING, INC.
 OIT # 1

NW NW NE Section 6-34S-13W
 Barber County, Kansas

Casing

8 5/8" set @ 352'
 5 1/2" - None

Cement

200 Sacks

Comm: 2-12-52
 Comp: 3-17-52
 Total Depth: 5502'

<u>FORMATION</u>	<u>DEPTH</u>
Sand & shale	0 - 50
Red bed	50 - 878
Red bed & shale	878 - 1250
Red bed	1250 - 1450
Shale & broken lime	1450 - 1770
Shale & shells	1770 - 2030
Broken lime	2030 - 2136
Lime	2136 - 2242
Shale & lime	2242 - 2340
Lime & shale	2340 - 3735
Lime	3735 - 3761
Sticky shale & lime	3761 - 3816
Lime & shale	3816 - 4361
Lime	4361 - 4742
Lime hard	4742 - 4763
Lime	4763 - 4867
Miss. Lime	4867 - 4906
Lime	4906 - 4975
Lime (hard)	4975 - 5017
Lime	5017 - 5113
Lime & shale	5113 - 5180
Lime - Viola	5180 - 5199
Lime	5199 - 5247
Cherty lime	5247 - 5254
Lime (Rough)	5254 - 5268
Cherty Lime	5268 - 5282
Lime & sand	5282 - 5306
Lime, shale & sand	5306 - 5337
Sand & lime	5337 - 5343
Sand, shale & lime	5343 - 5355
Sand & shale	5355 - 5412
Lime	5412 - 5441
Sand & shale	5441 - 5451
Arbuckle	5451 - 5460
Arbuckle Lime	5460 - 5495
Lime	5495 - 5502

STATE OF KANSAS)
) SS
 SEDGWICK COUNTY)

I hereby certify that the above information is true and correct
 to the best of my knowledge.



Subscribed and sworn to before me this 25th day of March, 1952.

PLUGGING
 FILE SEC-67 JRB-13W
 BOOK PAGE 2 LINE 21



Notary Public

My Commission expires: 12-19-55