


WELL PLUGGING RECORD

Give All Information Completely
Make Required Affidavit
Mail or Deliver Report to:
Conservation Division
State Corporation Commission
211 No. Broadway
Wichita, Kansas

Barber County, Sec. 10 Twp. 32 Rge. 15 (E) W (W)

Location as "NE/CNW/SW" or footage from lines NE-NE-NW
Lease Owner Aylward Drilling Company
Lease Name Skinner "W" Well No. 2
Office Address 813 First Nat'l Bk. Bldg., Wichita, Kansas
Character of Well (completed as Oil, Gas or Dry Hole) oil
Date well completed Sept. 25 19 58
Application for plugging filed April 7, 19 64
Application for plugging approved _____ 19 _____
Plugging commenced April 16 19 64
Plugging completed April 20, 19 64
Reason for abandonment of well or producing formation depleted

NORTH

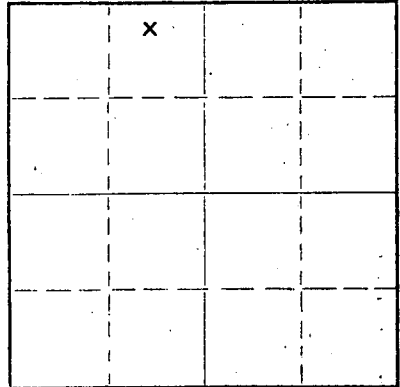

Locate well correctly on above
Section Plat

If a producing well is abandoned, date of last production _____ 19 _____
Was permission obtained from the Conservation Division or its agents before plugging was commenced? yes

Name of Conservation Agent who supervised plugging of this well Archie Elving
Producing formation _____ Depth to top _____ Bottom _____ Total Depth of Well 4895 Feet
Show depth and thickness of all water, oil and gas formations.

OIL, GAS OR WATER RECORDS

CASING RECORD

FORMATION	CONTENT	FROM	TO	SIZE	PUT IN	PULLED OUT
				8 5/8	310'	none
				5 1/2	4895.	3791.

Describe in detail the manner in which the well was plugged, indicating where the mud fluid was placed and the method or methods used in introducing it into the hole. If cement or other plugs were used, state the character of same and depth placed, from _____ feet to _____ feet for each plug set.

Filled with sand from 4895 to 4860 feet and dumped 5 sacks cement.
Set 10 foot rock bridge at 300 feet, mud to 250 feet
Set 10 foot rock bridge at 250 feet, and dumped 25 sacks cement.
Mud hole to 40 feet, set 5 foot rock bridge and dump 10 sacks cement.

RECEIVED
STATE CORPORATION COMMISSION
APR 24 1964
4-24-64
CONSERVATION DIVISION
Wichita, Kansas

(If additional description is necessary, use BACK of this sheet)
Name of Plugging Contractor Flint Engineering & Construction Co.
Address Box 950, El Dorado, Kansas

STATE OF Kansas, COUNTY OF Butler, ss. _____
(employee of owner) or (owner or operator) of the above-described well, being first duly sworn on oath, says: That I have knowledge of the facts, statements, and matters herein contained and the log of the above-described well as filed and that the same are true and correct. So help me God.

(Signature) Mary Payne
El Dorado, Kansas
(Address)

SUBSCRIBED AND SWORN TO before me this 22nd day of April, 19 64

My commission expires Sept. 27, 1967

Ronald R. Hansen
Notary Public.

SKINNER "W" NO. 2

Casing Records:

8 5/8" - 310'
5 1/2" - 4895'

Company: Aylward & Lewis
Contractor: Aylward Drilling Company

Commenced: September 9, 1958
Completed: September 25, 1958

Location: N₂ NE NW 10-32-15W
Barber County
Kansas

Elevation: 1960 R.B.

	<u>From</u>	<u>To</u>	<u>Remarks</u>
Sand	0	20	Set 8 5/8" surface pipe @ 310' w/270
Red Bed & Gyp	20	1230	sacks cement.
Anhydrite	1230	1270	
Shale & Shells	1270	1890	Geological Tops:
Shale & Lime	1890	2190	Heebner Shale 4098
Lime	2190	2725	Base/Oread 4132
Lime & Shale	2725	2890	Lansing 4275
Shale & Lime	2890	3400	Base/Kan. City 4721
Lime & Shale	3400	4111	Mississippian 4812
Mostly Lime, very little Shale	4111	4135	T.D. 4895
Sandy Lime & Shale	4135	4265	
Lime & Shale	4265	4306	
Lime	4306	4715	DST 4841-95 Open 1 hr. Gas surf./2"
Lime & Shale	4715	4760	277 MCFG/4", 196 MCFG/13". Fl. oil
Lime w/Shale	4760	4776	1 1/2 hrs. Rec. 120' SW.
Lime	4776	4807	IBHP 1540#/20" - FBHP 1525#/35"
Lime & Shale	4807	4864	FP 4407-4495#.
Lime	4864	4895 T.D.	Set 5 1/2" casing @ 4895' w/75 sacks
			cement.

RECEIVED
STATE CORPORATION COMMISSION

APR 24 1964
4-24-64
CONSERVATION DIVISION
Wichita, Kansas

I hereby certify that this is a true and correct copy of the above log to the best of my knowledge.

Paul W. Hesser

Subscribed and sworn to before me this 3rd day of October 1958.

Duane Jessup
Notary Public

My commission expires December 11, 1961

