


15-007-01753-0000

STATE OF KANSAS
STATE CORPORATION COMMISSION

Give All Information Completely
Make Required Affidavit
Mail or Deliver Report to:
Conservation Division
State Corporation Commission
211 No. Broadway
Wichita, Kansas

WELL PLUGGING RECORD

NORTH

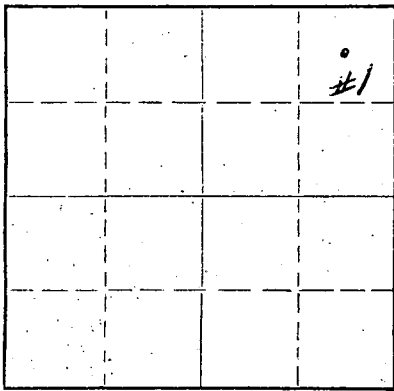

Locate well correctly on above
Section Plat

Barber County. Sec. 34 Twp. 32S Rge. 11W (E) (W)

Location as "NE/CNW4SW4" or footage from lines C NE NE

Lease Owner Sinclair Oil & Gas Company

Lease Name A. L. Thomas Well No. 1

Office Address P. O. Box 521, Tulsa, Oklahoma

Character of Well (completed as Oil, Gas or Dry Hole) Dry Hole

Date well completed October 20, 1957

Application for plugging filed October 21, 1957

Application for plugging approved October 23, 1957

Plugging commenced October 20, 1957

Plugging completed October 20, 1957

Reason for abandonment of well or producing formation Dry Hole no producing formation encountered

If a producing well is abandoned, date of last production None 19

Was permission obtained from the Conservation Division or its agents before plugging was commenced? Yes

Name of Conservation Agent who supervised plugging of this well Mr. M. A. Rives, Box 8, Pratt, Kansas

Producing formation None Depth to top Bottom Total Depth of Well 4945 Feet

Show depth and thickness of all water, oil and gas formations.

OIL, GAS OR WATER RECORDS:

CASING RECORD

FORMATION	CONTENT	FROM	TO	SIZE	PUT IN	PULLED OUT
None - Dry Hole				10-3/4	300'	None

Describe in detail the manner in which the well was plugged, indicating where the mud fluid was placed and the method or methods used in introducing it into the hole. If cement or other plugs were used, state the character of same and depth placed, from feet to feet for each plug set.

Filled hole from 4945' to 250' with heavy mud. Set Halliburton cement plug at 250' inside 10-3/4" OD casing. Dumped 35 sacks of cement from 250' to 183'. Filled Hole from 183' to 25' with heavy mud. Set Halliburton cement plug at 25'. Dumped 15 sacks of cement from 25' to base of cellar.

FILED
STATE CORPORATION COMMISSION

NOV 7 1957
11-7-57
CONSERVATION DIVISION
Wichita, Kansas

Name of Plugging Contractor Patton Drilling Company
Address Orpheum Bldg., Wichita, Kansas

STATE OF Kansas, COUNTY OF Rice, ss.
W. B. Rhees (employee of owner) or (owner) of the above-described

well, being first duly sworn on oath, says: That I have knowledge of the facts, statements, and matters herein contained and the log of the above-described well as filed and that the same are true and correct. So help me God.

(Signature) W. B. Rhees
P. O. Box 551, Chase, Kansas
(Address)

SUBSCRIBED AND SWORN TO before me this 5th day of November, 1957

My commission expires 21st October 1959 Notary Public.

PLUGGING
FILE SEC. 34 T. 32 R. 11W
BOOK PAGE 56 LINE 3

Sinclair Oil & Gas Company
A. L. Thomas Well # 1
Total Depth 4945'
Comm. 9/24/57
Comp. 10/20/57
Contractor Patton Drilling Co. Inc.

Location NE/4 Sec. 34-T32S-R11W
Barber County, Kansas.
CASING RECORD
10 3/4" Casing at 300' G.L.
Cemented with 250 Sacks.

Red Bed 330
Red Bed & Shale 640
Shale & Shells 1575
Lime & Shale 2240
Shale & Streaks of Lime 2310
Lime & Shale 3570
Shale 3705
Sandy Shale & Lime 3810
Lime & Shale 3835
Lime 4311
Lime & Shale 4444
Lime 4540
Lime & Shale 4658
Shale 4716
Lime & Shale 4721
Cherty Dolomite 4742
~~XXXX~~ Lime 4754
Lime Cherty 4768
Lime 4791
Lime & Shale 4810
Sandy Shale 4823
Sand 4856
Shale & Sand 4880
Shale 4945
Total Depth 4945

Ground Level Measurements

STATE OF Kansas COUNTY OF Sedgwick ss,

I, the undersigned, being duly sworn, on oath state that the above statement and log is a true and correct record and log of the well drilled at the location above described.

PATTON DRILLING COMPANY, INC.

By Robert W. Patton

Subscribed and sworn to before me this 30th day of October 1957

T. P. Hendrick
T. P. Hendrick Notary Public

My Commission expires Oct 4th 1960

RECEIVED
STATE CORPORATION COMMISSION

NOV 1 1957
11-1-57
CONSERVATION DIVISION
Wich Kansas

PLUGGING
FILE SEC 34 T 32 R 11 W
BOOK PAGE 56 LINE 3