

15.35.3000000

STATE OF KANSAS
STATE CORPORATION COMMISSION

Form CP-4


Give All Information Completely
Make Required Affidavit
Mail or Deliver Report to:
Conservation Division
State Corporation Commission
212 No. Market
Wichita, Kansas

WELL PLUGGING RECORD

Ness County. Sec. 27 Twp. 18S Rge. (E) 21 (W)

Location as "NE/CNW/SW" or footage from lines 100' NE of NE NW
Lease Owner James W. Hershberger
Lease Name PFAFF Well No. 1
Office Address 807 First National Bank Bldg., Wichita
Character of Well (completed as Oil, Gas or Dry Hole) Dry Hole
Date well completed April 24, 1966
Application for plugging filed 19
Application for plugging approved 19
Plugging commenced April 24, 1966
Plugging completed April 24, 1966
Reason for abandonment of well or producing formation Dry Hole

NORTH

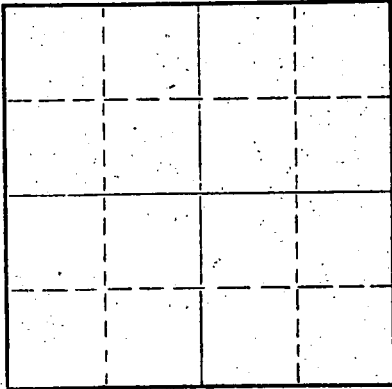

Locate well correctly on above
Section Plat

If a producing well is abandoned, date of last production 19
Was permission obtained from the Conservation Division or its agents before plugging was commenced? Yes

Name of Conservation Agent who supervised plugging of this well Leo Massey, Hays, Kansas
Producing formation _____ Depth to top _____ Bottom _____ Total Depth of Well 4210 Feet
Show depth and thickness of all water, oil and gas formations.

OIL, GAS OR WATER RECORDS

CASING RECORD

FORMATION	CONTENT	FROM	TO	SIZE	PUT IN	PULLED OUT
	Surface	0	305'	8-5/8"	4/16/66	
	Casing					

Describe in detail the manner in which the well was plugged, indicating where the mud fluid was placed and the method or methods used in introducing it into the hole. If cement or other plugs were used, state the character of same and depth placed, from _____ feet to _____ feet for each plug set.

Filled hole with heavy mud and squeezed
by Halliburton with 125 sacks cement and
HOWCO Plug. Job completed at 9:15 A.M.

RECEIVED
STATE CORPORATION COMMISSION

APR 27 1966

CONSERVATION DIVISION
Wichita, Kansas

(If additional description is necessary, use BACK of this sheet)

Name of Plugging Contractor Sage Drilling Co., Inc.
Address 500 Bitting Building, Wichita, Kansas

STATE OF KANSAS, COUNTY OF SEDGWICK, ss.
Lawrence F. Gray (employee of owner) or (owner or operator) of the above-described well, being first duly sworn on oath, says: That I have knowledge of the facts, statements, and matters herein contained and the log of the above-described well as filed and that the same are true and correct. So help me God.

(Signature) Lawrence F. Gray
500 Bitting Building, Wichita, Kansas (Address)

SUBSCRIBED AND SWORN TO before me this 25th day of April, 1966

My commission expires November 26, 1966.

Louise K. Whitted
Louise K. Whitted - Notary Public.

15-135-3216-0000

DRILLERS LOG

PFAFF NO. 1

CASING RECORD:	COMPANY:	James W. Hershberger	DESCRIPTION:
8-5/8" @ 305' w/200 sax cement	CONTRACTOR:	Sage Drilling Co.	100' NE of NE NW Sec. 27-18S-21W Ness County, Kansas
TOTAL DEPTH:	COMMENCED:	April 15, 1966	Elevation: 2108 KB
4210'	COMPLETED:	April 24, 1966	

<u>FORMATION</u>	<u>FROM</u>	<u>TO</u>	<u>REMARKS</u>
Surface Soil	0	305	
Shale	305	776	
Dakota Sand	776	982	
Shale	982	1109	
Shale & Shells	1109	1336	
Anhydrite	1336	1365	
Red Bed, Shale & Shells	1365	1684	
Sand, Red Bed & Shale	1684	2400	
Lime & Shale	2400	2738	
Shale & Lime	2738	2980	
Chalky Lime & Shale	2980	3180	
Lime & Shale	3180	3843	
Lime	3843	3915	
Lime & Shale	3915	4141	
Cherty Lime	4141	4210	

RECEIVED
STATE CORPORATION COMMISSION

APR 27 1966

CONSERVATION DIVISION
Wichita, Kansas

I certify that this is a true and correct copy of the above log to the best of my knowledge.

SAGE DRILLING COMPANY, INC.

By

Lawrence F. Gray

Lawrence F. Gray

Subscribed and sworn to before me this 25th day of April, 1966.

Louise K. Whitted
Louise K. Whitted, Notary Public

My commission expires:
November 26, 1966.