


15-007-10130-0000

STATE OF KANSAS
STATE CORPORATION COMMISSION

Give All Information Completely
Make Required Affidavit
Mail or Deliver Report to:
Conservation Division
State Corporation Commission
800 Biting Building
Wichita, Kansas

WELL PLUGGING RECORD

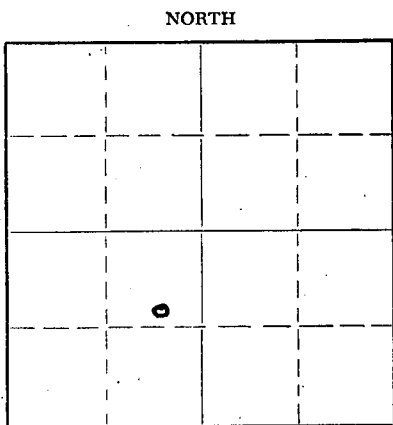

Locate well correctly on above
Section Plat

Barber County, Sec. 23 Twp. 32S Rge. (E) 15(W)
Location as "NE/CNW/SW" or footage from lines CS 1/2 - NE 1/4 - SW 1/4
Lease Owner Champlin Refining Company
Lease Name Hildebrand Well No. 7
Office Address P.O. Dr. #552, Enid, Oklahoma
Character of Well (completed as Oil, Gas or Dry Hole) Oil & gas
Date well completed October 18, 1946
Application for plugging filed August 13, 1952
Application for plugging approved August 20, (Verbal) 1952
Plugging commenced August 20, 1952
Plugging completed August 28, 1952
Reason for abandonment of well or producing formation Non-productive

If a producing well is abandoned, date of last production January 1949
Was permission obtained from the Conservation Division or its agents before plugging was commenced? Yes

Name of Conservation Agent who supervised plugging of this well Merle Rives, Pratt, Kansas
Producing formation _____ Depth to top _____ Bottom _____ Total Depth of Well 4987 Feet
Show depth and thickness of all water, oil and gas formations. P.B.T.D.

OIL, GAS OR WATER RECORDS

CASING RECORD

FORMATION	CONTENT	FROM	TO	SIZE	PUT IN	PULLED OUT
				10 3/4" OD	480'	None
				5 1/2" OD	4964'	2662'

Describe in detail the manner in which the well was plugged, indicating where the mud fluid was placed and the method or methods used in introducing it into the hole. If cement or other plugs were used, state the character of same and depth placed, from _____ feet to _____ feet for each plug set.

Plugged back with chat from 4987' P.B.T.D. to 4950'. Dumped 5 sacks cement, filling hole from 4950' to 4915' then filled hole with heavy mud from 4915' to 300' and set rock bridge and cement bridge using 20 sacks of cement filling hole to 260' then filled hole with heavy mud from 260' to 20' and set rock bridge and filled hole to top with cement using 10 sacks cement.

RECEIVED
STATE CORPORATION COMMISSION
SEP 8 1952
7-8-52
CONSERVATION DIVISION
Wichita, Kansas

(If additional description is necessary, use BACK of this sheet)
Name of Plugging Contractor Miller Casing Pulling Co.
Address Great Bend, Kansas

STATE OF Kansas, COUNTY OF Barton, ss.
S. P. Hall (employee of owner) or (owner or operator) of the above-described well, being first duly sworn on oath, says: That I have knowledge of the facts, statements, and matters herein contained and the log of the above-described well as filed and that the same are true and correct. So help me God.

(Signature) S. P. Hall
P.O. Box 167, Ellinwood, Kansas
(Address)

SUBSCRIBED AND SWORN to before me this 5th day of September, 1952

My commission expires Sept. 10, 1955

M. Kenneth Steiner
Notary Public.

PLUGGING
FILE SEC 23 T 32 R 15W
BOOK PAGE 37 LINE 4V

15-007-10130-0000

CHAMPLAIN REFINING COMPANY

HILDEBRAND #7

Center of S $\frac{1}{2}$ -NE-SW of Section 23-32-15W
BARBER COUNTY, KANSAS

0'	40'	Surface Clay
40'	410'	Red Bed, Lime & Shells
410'	500'	Red Bed
500'	600'	Red Bed, Lime & Shells
600'	885'	Shale, Lime & Shells
885'	1200'	Salt, Anhydrite
1200'	1400'	Shale & Lime
1400'	1595'	Shale & Lime
1595'	1805'	Lime & Shale
1805'	1930'	Lime & Shale
1930'	2110'	Lime & Shale
2110'	2215'	Lime & Shale
2215'	2295'	Lime & Shale
2295'	2345'	Lime
2345'	2410'	Lime
2410'	2470'	Lime
2470'	2490'	Lime
2490'	2530'	Shale
2530'	2595'	Shale & Lime
2595'	2665'	Lime & Shale
2665'	2735'	Shale & Lime
2735'	2780'	Lime
2780'	2835'	Lime
2835'	2880'	Lime, Shale & Hard Sand
2880'	2975'	Lime & Shale
2975'	3055'	Shale
3055'	3125'	Shale & Lime
3125'	3195'	Shale & Lime
3195'	3270'	Lime & Shale
3270'	3370'	Shale & Lime
3370'	3435'	Lime & Shale
3435'	3470'	Lime & Shale
3470'	3580'	Shale & Lime
3580'	3660'	Lime & Shale
3660'	3730'	Lime & Shale
3730'	3770'	Shale & Lime
3770'	3860'	Shale & Lime
3860'	3905'	Lime
3905'	3960'	Lime & Shale
3960'	4040'	Shale & Lime
4040'	4080'	Lime
4080'	4135'	Lime & Shale
4135'	4190'	Lime & Shale
4190'	4200'	Lime & Shale
4200'	4320'	Shale, Sand & Lime
4320'	4360'	Lime
4360'	4410'	Lime
4410'	4450'	Lime
4450'	4505'	Lime
4505'	4535'	Lime & Shale
4535'	4570'	Shale & Lime
4570'	4590'	Lime
4590'	4635'	Lime & Shale
4635'	4660'	Lime
4660'	4695'	Lime & Shale
4695'	4725'	Shale
4725'	4755'	Shale
4755'	4785'	Shale & Lime
4785'	4805'	Lime
4805'	4840'	Lime
4840'	4880'	Lime & Shale
4880'	4915'	Lime & Shale
4915'	4940'	Shale & Lime
4940'	4970'	Lime
4970'	4980'	Lime
4980'	4987'	Lime
4987'		TOTAL DEPTH

RECORDED
STATE CORP. 12-21-50
DEC 21 1950
CONSERVATION DIVISION
Wichita, Kansas

PLUGGING
WELL SEC 23 T 32 R 15 W
BOOK PAGE 9 LINE 40