


15-007 10129-0000

STATE OF KANSAS
STATE CORPORATION COMMISSION

WELL PLUGGING RECORD

Give All Information Completely
Make Required Affidavit
Mail or Deliver Report to:
Conservation Division
State Corporation Commission
800 Bitting Building
Wichita, Kansas

NORTH

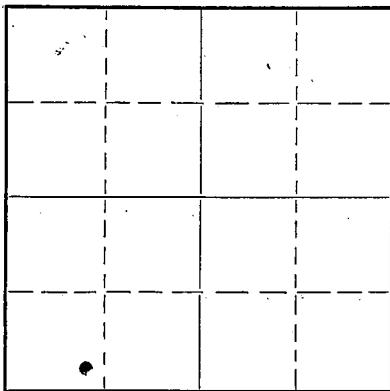

Locate well correctly on above
Section Plat

Barber County, Sec. 23, Twp. 32S, Rge. (E) 15 (W)

Location as "NE/CNW $\frac{1}{4}$ SW $\frac{1}{4}$ " or footage from lines SE $\frac{1}{4}$ -SW $\frac{1}{4}$ -SW $\frac{1}{4}$

Lease Owner Champlin Refining Company

Lease Name Mills Well No. 2

Office Address Dr. #552, Enid, Oklahoma.

Character of Well (completed as Oil, Gas or Dry Hole) Oil & Gas

Date well completed November 30, 19 46

Application for plugging filed December 5, 19 50

Application for plugging approved December 19, 1950 19 50

Plugging commenced December 19, 19 50

Plugging completed December 23, 19 50

Reason for abandonment of well or producing formation Non-productive

If a producing well is abandoned, date of last production January 5, 19 48

Was permission obtained from the Conservation Division or its agents before plugging was commenced? Yes

Name of Conservation Agent who supervised plugging of this well Mr. C. D. Stough, Great Bend, Kansas.

Producing formation 4912' Viola Depth to top 4912' Bottom Total Depth of Well 4957' Feet

Show depth and thickness of all water, oil and gas formations.

OIL, GAS OR WATER RECORDS

CASING RECORD

Formation	Content	From	To	Size	Put In	Pulled Out
				9"	480'	None
				5 $\frac{1}{2}$ "	4957'	627' 11"

Describe in detail the manner in which the well was plugged, indicating where the mud fluid was placed and the method or methods used in introducing it into the hole. If cement or other plugs were used, state the character of same and depth placed, from _____ feet to _____ feet for each plug set.

& aquajel
Filled hole with heavy rotary mud from 4957' T.D. to 628' or to top of 5 $\frac{1}{2}$ " casing left in well and used Halliburton to pump in 500 sacks of cement on top of casing and mud and into formations top of cement came to 228' then filled hole with heavy rotary mud from 228' to 10' from bottom of cellar and set cement plug in top from 10' to bottom of cellar using 5 sacks of cement.

RECEIVED
STATE CORPORATION COMMISSION
1-2-51
JAN 2 1951
CONSERVATION DIVISION
Wichita, Kansas

(If additional description is necessary, use BACK of this sheet)

Correspondence regarding this well should be addressed to Champlin Refining Company
Address P. O. Dr. #552, Enid, Oklahoma.

STATE OF Kansas, COUNTY OF Barton, ss.
S. P. Hall (employee of owner) or (Notary Public) of the above-described well,

being first duly sworn on oath, says: That I have knowledge of the facts, statements, and matters herein contained and the log of the above-described well as filed and that the same are true and correct. So help me God.

(Signature) S. P. Hall

Box 167, Ellinwood, Kansas. (Address)

SUBSCRIBED AND SWORN to before me this 29th day of December, 19 50

October 24, 1951
M. Kenneth Stivers Notary Public.

My commission expires

22-7877-8 4-49-10M

PLUGGING
FILE SEC 23 T 32 R 15 W
BOOK PAGE 47 LINE 11

15-007-10129-0000
CHAMPLIN REFINING COMPANY
FORMATION LOG

MILLS #2 WELL LOCATED SE $\frac{1}{4}$ -SW $\frac{1}{4}$ -SW $\frac{1}{4}$ of SEC.
23-32s-16w Barber County, Kansas

0'	-	35'	Red Bed
35'	-	480'	Red Bed Set 480' of 9" casing w/ 250 sacks cement.
480'	-	610'	Red bed and shells
610'	-	1030'	Red bed, shale and shells
1030'	-	1300'	Shale and shells
1300'	-	1540'	Shale and shells
1540'	-	1750'	Shale, Lime and shells
1750'	-	1895'	Shale and Gyp
1895'	-	2075'	Shale and shells
2075'	-	2140'	Lime and Gyp
2140'	-	2200'	Gyp and Lime
2200'	-	2260'	Lime
2260'	-	2300'	Lime
2300'	-	2355'	Lime, sandy
2355'	-	2440'	Lime and shale
2440'	-	2470'	Lime and shale
2470'	-	2490'	Sand
2490'	-	2545'	Lime and chert
2545'	-	2595'	Lime and chert
2595'	-	2650'	Shale, Lime and Sand
2650'	-	2695'	Sand, Lime and shale
2695'	-	2730'	Lime and shale
2730'	-	2760'	Shale and Lime
2760'	-	2800'	Lime
2800'	-	2845'	Lime and shale
2845'	-	2895'	Lime, Sand and shale
2895'	-	2950'	Shale and lime
2950'	-	3010'	Lime and Shale
3010'	-	3070'	Shale and lime
3070'	-	3130'	Lime and shale
3130'	-	3180'	Shale and Lime
3180'	-	3345'	Lime and shale
3345'	-	3623'	Lime and Shale
3623'	-	3680'	Lime broken
3680'	-	3720'	Lime
3720'	-	3945'	Shale and Lime
3945'	-	3955'	Lime
3955'	-	4005'	Shale
4005'	-	4240'	Lime and shale
4240'	-	4490'	Lime
4490'	-	4520'	Lime and streaks of chert
4520'	-	4630'	Lime
4630'	-	4640'	Hard Lime
4640'	-	4700'	Lime and shale
4700'	-	4760'	Lime
4760'	-	4790'	Lime and shale
4790'	-	4912'	Lime and shale
4912'	-	4957'	Lime
4957'	-		TOTAL DEPTH

RECEIVED
STATE CORPORATION COMMISSION
12-7-50
DEC 7 - 1950
CONSERVATION DIVISION
Wichita, Kansas

PLUGGING
WELL SEC 23-32-16W
BOOK PAGE 47 LINE 11