


STATE OF KANSAS
STATE CORPORATION COMMISSION

WELL PLUGGING RECORD

Give All Information Completely
Make Required Affidavit
Mail or Deliver Report to
Conservation Division
State Corporation Comm.
245 North Water
Wichita, KS 67202

Barber County. Sec. 18 Twp. 32 Rge. 15 E/W
Location as "NE/CNW $\frac{1}{4}$ SW $\frac{1}{4}$ " or footage from lines
C N/2 NW

Lease Owner Messman-Rinehart Corporation
Lease Name Welsh B Well No. 1
Office Address 1432 Vickers-KSB&T Bldg., Wichita, Ks.
Character of Well (Completed as Oil, Gas or Dry Hole) 67202
oil

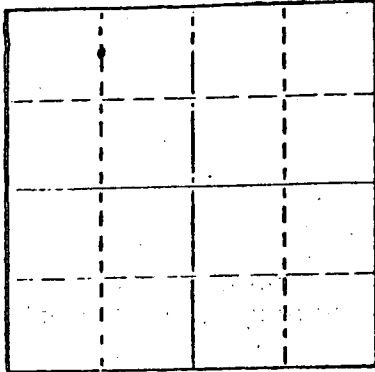

Locate well correctly on above
Section Plot

Date Well completed 19
Application for plugging filed 19
Application for plugging approved April 20 19 77
Plugging commenced June 6 19 77
Plugging completed June 22 19 77
Reason for abandonment of well or producing formation
depleted

If a producing well is abandoned, date of last production 19

Was permission obtained from the Conservation Division or
its agents before plugging was commenced? yes

Name of Conservation Agent who supervised plugging of this well Jasper H. Metz
Producing formation _____ Depth to top _____ Bottom _____ Total Depth of Well 4878'
Show depth and thickness of all water, oil and gas formations.

OIL, GAS OR WATER RECORDS

CASING RECORD

FORMATION	CONTENT	FROM	TO	SIZE	PUT IN	PULLED OUT
			228'	10 3/4"	228'	none
			4834'	5 1/2"	4834'	2620.28

Describe in detail the manner in which the well was plugged, indicating where the mud fluid
was placed and the method or methods used in introducing it into the hold. If cement or other
plugs were used, state the character of same and depth placed, from _____ feet to
_____ feet for each plug set.

Sanded back to 4700' and dumped 5 sacks of cement.

Set bridge at 250' and plugged well with 5 yards of ready mix cement.

RECEIVED
STATE CORPORATION COMMISSION

JUL 11 1977
7-11-77
CONSERVATION DIVISION
Wichita, Kansas

Name of Plugging Contractor PIPE PULLERS, INC.
Box 128, Ellinwood, Kansas 67526

STATE OF KANSAS COUNTY OF BARTON ss.
Evelyn Roth (employee of owner) or (owner or operator) of the above-described

well, being first duly sworn on oath, says: That I have knowledge of the facts, statements, and matters herein contained and the log of the
above-described well as filed and that the same are true and correct. So help me God.

(Signature) Evelyn Roth
Ellinwood, Kansas (Address)

Subscribed and Sworn to before me this 7th day of July 19 77

My commission expires

JENNY KASSELMAN
NOTARY PUBLIC
BARTON COUNTY, KANSAS
MY COMM. EXP. JULY 16, 1978

Jenny Kasselmann
Notary Public.

NO. 1 WELSH "B"

Well Record:

Location: App. C. N/2 NW/4,
Sec. 18-32S-15W
Barber County, Kansas
Commenced: February 12, 1960
Completed: February 28, 1960
(Rotary)
Operator: Messman-Rinehart Oil Company
518 Petroleum Building
Wichita, Kansas
Elevation: 1905' K/B
Production: Gas
Contractor: Messman-Rinehart Oil Company
518 Petroleum Building
Wichita, Kansas
Casing Record: 10-3/4" @ 228' w/200 sx. cement
5-1/2" @ 4834' w/110 sx. cement

--- L O O ---

Clay & sand	98
Gyp Rock	110
Red Bed	835
Anhydrite	855
Red Bed, shale & shells	1465
Shale	1900
Shale & salt	2000
Lime & shale	2130
Lime	2345
Lime & shale	2500
Lime	2595
Lime & shale	4205
Shale	4253
Lime & shale	4370
Lime	4414
Lime & shale	4465
Lime	4505
Lime & chert	4530
Lime & shale	4570
Lime	4600
Lime & chert	4630
Lime	4680
Lime & shale	4748
Mississippi	4788
Lime & chert	4838
Lime, shale & chert	4855
Lime & chert	4878 R.T.D.

Sample Tops:

4038 - Heobner (-2133)
4121 - Douglas sand (-2216)
4193 - Lansing (-2288)
4748 - Mississippian (-2843)

RECEIVED
STATE GEOLOGICAL COMMISSION

JUL 20 1977
7-20-77
CONSERVATION DIVISION
Wichita, Kansas

The undersigned, MESSMAN-RINEHART OIL COMPANY, hereby certifies that the above log is a true and correct log of the formation encountered in drilling the above well as reflected by the Daily Drilling Reports.

MESSMAN-RINEHART OIL COMPANY

By: J. A. Gilliland
J. A. Gilliland

Subscribed and sworn to before me
this 15th day of March, 1960.

Barbara J. Scott
Barbara J. Scott, Notary Public

My Commission Expires: December 1, 1960