


STATE OF KANSAS  
STATE CORPORATION COMMISSION

WELL PLUGGING RECORD

Give All Information Completely  
Make Required Affidavit  
Mail or Deliver Report to  
Conservation Division  
State Corporation Comm.  
245 North Water  
Wichita, KS 67202

Barber County, Sec. 35 Twp. 32 Rge. 15 E/W  
Location as "NE/CNW 1/4 SW 1/4" or footage from lines  
S/2 NE NW  
Lease Owner Raymond Oil Co., Inc.  
Lease Name Hildebrand #13 Well No. \_\_\_\_\_  
Office Address Wichita, Kansas 67202  
Character of Well (Completed as Oil, Gas, or Dry Hole) \_\_\_\_\_

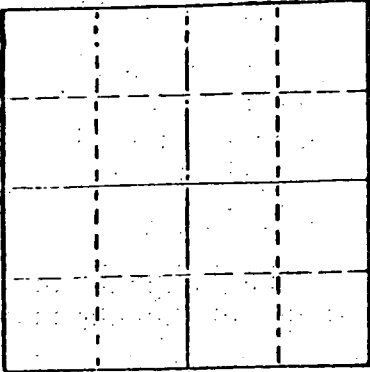

Locate well correctly on above  
Section Plat

Date Well completed \_\_\_\_\_ 19  
Application for plugging filed \_\_\_\_\_ 19  
Application for plugging approved \_\_\_\_\_ 19  
Plugging commenced 7/7/77 \_\_\_\_\_ 19  
Plugging completed 7/22/77 \_\_\_\_\_ 19  
Reason for abandonment of well or producing formation  
depleted.

If a producing well is abandoned, date of last production \_\_\_\_\_ 19

Was permission obtained from the Conservation Division or  
its agents before plugging was commenced? yes

Name of Conservation Agent who supervised plugging of this well Metz  
Producing formation \_\_\_\_\_ Depth to top \_\_\_\_\_ Bottom \_\_\_\_\_ Total Depth of Well 5048  
Show depth and thickness of all water, oil and gas formations.

OIL, GAS OR WATER RECORDS

CASING RECORD

FORMATION	CONTENT	FROM	TO	SIZE	PUT IN	PULLED OUT
				10-3/4	519	none
				7"	5048	538'

Describe in detail the manner in which the well was plugged, indicating where the mud fluid was placed and the method or methods used in introducing it into the hold. If cement or other plugs were used, state the character of same and depth placed, from \_\_\_\_\_ feet to \_\_\_\_\_ feet for each plug set.

Ran 1500 # of sand, checked sand, did not have enough fill up. Ran 1500# more sand. Shot pipe at 3039', worked pipe loose, loaded casing with one load water, pipe stuck. Pumped pipe loose with 60 barrels water, pulled 1 joint, pipe stuck. Tried to pump pipe loose, circulated pipe with mud, did not get loose. Spotted 60 barrel s oil, worked pipe. Circulated pipe, did not get loose. Shot pipe at 1500, 1260, 922, 823, 700, 670, 520, pulled 19 joints. Set rock bridge at 280' and ran 6 yards ready mix.

PLUGGING COMPLETE.

(If additional description is necessary, use BACK of this sheet)

Name of Plugging Contractor VOTH CASING PULLING  
CHASE, KANSAS

STATE OF KANSAS COUNTY OF RICE, ss.  
WALTER VOTH (employee of owner) or (owner or operator)  
of the above-described well, being first duly sworn on oath, says: That I have knowledge of the facts, statements, and matters herein contained and the log of the above-described well as filed and that the same are true and correct. So help me God.

(Signature) Walter Voth  
CHASE, KANSAS

SUBSCRIBED AND SWORN TO before me this 29th day of July, 19 77

(Address)  
Margaret Melches  
Notary Public.

My commission expires \_\_\_\_\_

15-007-01362-0000

WELL LOG BUREAU - KANSAS GEOLOGICAL SOCIETY

COPY

508 L. Murdock,

Wichita, Kansas

Company - CHAMPLIN REFG. CO.

Farm - Wildebrand

No. 13

SEC. 35  
CS<sub>2</sub> NE NW

T. 32

R. 15W

Total Depth. 5048

Comm. 5-16-50

Shot or Treated.


Contractor.

Issued. 8-19-50

Comp. 6-13-50

County. Barber

KANSAS

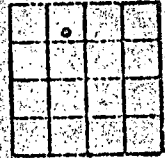

Elevation. 1967

Production. 50 bbls. oil

CASING:  
10 3/4" 519' cem. w/300 sx.  
7" OD 5048' cem. w/300 sx.

Figures Indicate Bottom of Formations.

cellar	10
sand, redbed	115
red bed, shale	535
shale red, shells	950
shale, lime	1400
shale, shells	1430
shale, salt	1500
shale, lime	1660
anhyd.	1690
lime, shale	1790
lime	1910
anhyd.	1980
shale, shells	2035
shale	2070
lime	2130
anhyd., shale	2205
lime	2500
lime, shale	2570
lime	2600
lime, shale	2735
lime	2770
lime, shale	3385
lime broken	3460
lime, shale	3545 ?
lime	3640
lime sdy	3685
lime	3730
lime, shale	3934
shale	3990
shale, lime	4034
shale, lime sdy	4093
shale	4103
lime sdy	4131
lime	4184
shale, lime sdy	4226
sand	4238
shale	4265
lime	4505
lime, shale	4529
lime	4604
lime, shale	4631
lime	4641
shale	4653
lime	4690
lime, shale	4715
lime	4997
shale	5012
lime	5022
lime chty	5048
Total Depth	

Tops:	
Douglas sand	4225
Woodford	4980
Viola	4988

RECEIVED  
STATE CORPORATION COMMISSION

6-2-77