

15-007-00688-0000


STATE OF KANSAS
STATE CORPORATION COMMISSION

Form CP-4

WELL PLUGGING RECORD

Give All Information Completely
Make Required Affidavit
Mail or Deliver Report to:
Conservation Division
State Corporation Commission
211 No. Broadway
Wichita, Kansas

NORTH

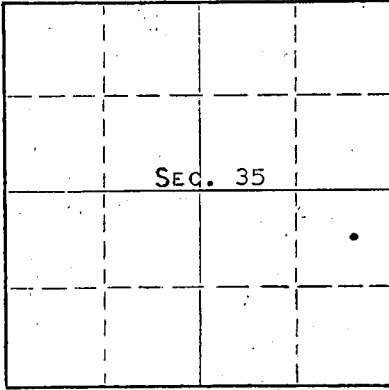

Locate well correctly on above
Section Plat

BARBER County. Sec. 35 Twp. 32s Rge. 15W (X) (W)
Location as "NE/CNW/SE" or footage from lines APPROX. NE SE
Lease Owner PETROLEUM, INC.,
Lease Name DEGEER Well No. 1
Office Address ROUTE 2, GREAT BEND, KANSAS
Character of Well (completed as Oil, Gas or Dry Hole) DRY HOLE
Date well completed JULY 1, 1963
Application for plugging filed JULY 1, 1963
Application for plugging approved JULY 1, 1963
Plugging commenced JULY 1, 1963
Plugging completed JULY 1, 1963
Reason for abandonment of well or producing formation NO PRODUCIBLE FORMATIONS

If a producing well is abandoned, date of last production NONE 19
Was permission obtained from the Conservation Division or its agents before plugging was commenced? YES

Name of Conservation Agent who supervised plugging of this well ARCHIE ELVING
Producing formation - - Depth to top - - Bottom - - Total Depth of Well 5230 Feet
Show depth and thickness of all water, oil and gas formations.

OIL, GAS OR WATER RECORDS

CASING RECORD

FORMATION	CONTENT	FROM	TO	SIZE	PUT IN	PULLED OUT
				13-3/8"	276'	NONE

Describe in detail the manner in which the well was plugged, indicating where the mud fluid was placed and the method or methods used in introducing it into the hole. If cement or other plugs were used, state the character of same and depth placed, from feet to feet for each plug set.

MUDDED UP WITH HEAVY MUD TO 240' FOLLOWED BY WOODEN PLUG AND 1/2 SACK HULLS.
PLACED 30 SACKS CEMENT THROUGH DRILL PIPE ONTO HULLS. MUDDED UP WITH HEAVY MUD TO 40', FOLLOWED BY WOODEN PLUG, 1/2 SACK HULLS AND 20 SACKS CEMENT TO BASE OF WELL CELLAR. PLACED 2 SACKS CEMENT IN RAT HOLE AND 2 SACKS CEMENT IN MOUSE HOLE.

RECEIVED
STATE CORPORATION COMMISSION

JUL 15 1963

7-15-63

CONSERVATION DIVISION
Wichita, Kansas

(If additional description is necessary, use BACK of this sheet)

Name of Plugging Contractor GARVEY DRILLING COMPANY
Address ROUTE 2, GREAT BEND, KANSAS

STATE OF KANSAS, COUNTY OF BARTON, ss.
DON SEARLE (employee of owner) or (operator) of the above-described well, being first duly sworn on oath, says: That I have knowledge of the facts, statements, and matters herein contained and the log of the above-described well as filed and that the same are true and correct. So help me God.

DON SEARLE, DIST. PROD. SUPT.
(Signature) *Don Searle*
ROUTE 2, GREAT BEND, KANSAS
(Address)

SUBSCRIBED AND SWORN TO before me this 11TH day of JULY, 1963

My commission expires APRIL 14, 1967

Arthur J. Miles
Notary Public.

COMPANY Petroleum Inc

SEC. 35 T. 32S R. 15W

FARM De Geer

NO. 1

LOC. App NE SE


TOTAL DEPTH 5230'

COUNTY Barber

COMM. 6-11-63

COMP. 7-1-63

CONTRACTOR Garvey Drilling Company

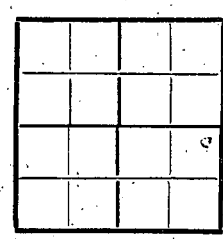

CASING 13 3/8" @ 276' w/250 sx

ELEVATION 2006' D.F.

PRODUCTION D & A

FIGURES INDICATE BOTTOM OF FORMATIONS

- 115' Surface Soil & Sand
- 145' Red Bed
- 165' Gyp
- 276' Shale
- 1196' Red Bed
- 1680' Red Bed & Shale
- 1850' Shale and Shells
- 1980' Shale and Lime
- 2100' Shale w/Lime Streaks
- 2645' Lime
- 3982' Lime and Shale
- 4032' Shale and Lime
- 4304' Lime and Shale
- 5017' Lime
- 5044' Lime and Chert
- 5095' Lime
- 5199' Lime and Shale
- 5214' Lime and Chert
- 5230' Lime
- 5230' RTD

RECEIVED
STATE CORPORATION COMMISSION
JUL 15 1963
7-15-63
CONSERVATION DIVISION
Wichita, Kansas

State of Kansas }
County of Barton } ss

I, Sam N. Stephens of Garvey Drilling Company

upon oath state the above and foregoing is a true and correct copy of the log of the De Geer #1 well.

Sam N. Stephens

Subscribed and sworn to before me this 11th day of July 19 63

My Commission Expires: April 14th, 1967

Arthur J. Miles
NOTARY PUBLIC