

CARD MUST BE TYPED

State of Kansas
NOTICE OF INTENTION TO DRILL
(see rules on reverse side)

CARD MUST BE SIGNED

Starting Date: 1 22 85
month day year

API Number 15- 007-22,000-0000

OPERATOR: License # 5422

SE NW NE Sec. 31 Twp. 31. S, Rge. 14. East
(location) West

Name Abercrombie Drilling, Inc.

Address 801 Union Center

City/State/Zip Wichita, KS 67202

Contact Person Jack L. Partridge

Phone 316-262-1841

..... 4290... Ft North from Southeast Corner of Section

..... 1650... Ft West from Southeast Corner of Section

(Note: Locate well on Section Plat on reverse side)

CONTRACTOR: License # 5422

Name Abercrombie Drilling, Inc.

City/State Wichita, KS 67202

Nearest lease or unit boundary line 990 feet.

County Barber

Lease Name Mills Well# 1

Domestic well within 330 feet: yes no

Municipal well within one mile: yes no

Well Drilled For: Well Class: Type Equipment:

- Oil Swd Infield Mud Rotary
- Gas Inj Pool Ext. Air Rotary
- OWWO Expl Wildcat Cable

Depth to Bottom of fresh water 200 feet

Lowest usable water formation Permian

Depth to Bottom of usable water 200 feet

Surface pipe by Alternate: 1 # 2 #

Surface pipe to be set 350 feet

Conductor pipe if any required None feet

Ground surface elevation 1900 feet MSI.

This Authorization Expires 7-18-85

Approved By 1-18-85 [Signature]

If OWWO: old well info as follows:

Operator

Well Name

Comp Date Old Total Depth

Projected Total Depth 4850 feet

Projected Formation at TD Simpson

Expected Producing Formations Douglass-Viola-Simpson

I certify that we will comply with K.S.A. 55-101, et seq., plus eventually plugging hole to K.C.C. specifications.

Date 1-17-85 Signature of Operator or Agent

[Signature]

Jack L. Partridge

Title V.P. Abercrombie Drilling

Form C-1 4/84


mhc/MOHE 1-18-85

Must be filed with the K.C.C. five (5) days prior to commencing well
This card void if drilling not started within six (6) months of date received by K.C.C.
Wichita, Kansas
CONSERVATION DIVISION

JAN 18 1988
88-81-1
STANDARD REGULAR SECTION
1 Mile

Important procedures to follow:

1. Notify District office before setting surface casing.
2. Set surface casing by circulating cement to the top.
3. File completion forms ACO-1 with K.C.C. within 90 days of well completion, following instructions on ACO-1, side 1, and including copies of wireline logs.
4. Notify District office 48 hours prior to old well workover or re-entry.
5. Prior to plugging, prepare a plugging plan, then obtain agreement from the appropriate district office for an approved plugging plan.
6. Submit plugging report (CP-4) to K.C.C. after plugging is completed.
7. Obtain an approved injection docket number before disposing of salt water.
8. Notify K.C.C. within 10 days when injection commences or terminates.
9. If an alternate 2 completion, cement in the production pipe from below any usable water to surface within 120 days of spud date.

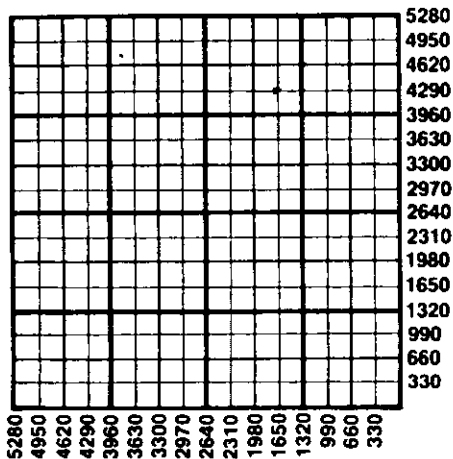

**State Corporation Commission of Kansas
Conservation Division
200 Colorado Derby Building
Wichita, Kansas 67202
(316) 263-3238**