

CARD MUST BE TYPED

State of Kansas  
**NOTICE OF INTENTION TO DRILL**  
(see rules on reverse side)

CARD MUST BE SIGNED

Starting Date: June 19, 1985  
month day year

API Number 15- 135-22,846-0000

OPERATOR: License # 5804  
Name: Drilling Ltd. of Colorado  
Address: 410 - 17th St., Suite 1140  
City/State/Zip: Denver, Colorado 80202  
Contact Person: Les Olson  
Phone: 303-623-6144

API Number 15- 135-22,846-0000  
NW, SE, NE, SW Sec. 24, Twp. 19 S, Rge. 22 E  
(location)  
3630 Ft North from Southeast Corner of Section  
990 Ft West from Southeast Corner of Section  
(Note: Locate well on Section Plat on reverse side)

CONTRACTOR: License # 5815  
Name: C. and R. Drilling Co.  
City/State: Denver, Colorado 80202

Nearest lease or unit boundary line 990 feet.  
County: Ness  
Lease Name: Wegele Well# 1

Well Drilled For: Well Class: Type Equipment:  
 Oil  Swd  Infield  Mud Rotary  
 Gas  Inj  Pool Ext.  Air Rotary  
 OWWO  Expl  Wildcat  Cable

Domestic well within 330 feet:  yes  no  
Municipal well within one mile:  yes  no

If OWWO: old well info as follows:

Operator  
Well Name  
Comp Date Old Total Depth  
Projected Total Depth 4550 feet  
Projected Formation at TD: Mississippian  
Expected Producing Formations: Mississippian

Depth to Bottom of fresh water 300 412 E feet  
Lowest usable water formation Dakota  
Depth to Bottom of usable water 600 feet  
Surface pipe by Alternate: 1  2   
Surface pipe to be set 400 feet  
Conductor pipe if any required None feet  
Ground surface elevation Approx. 2220 feet MSL  
This Authorization Expires 12-19-85  
Approved By 6-19-85 R

I certify that we will comply with K.S.A. 55-101, et seq., plus eventually plugging hole to K.C.C. specifications. Production String will be

Date 6-12-85 Signature of Operator for Agent



Title Drilling Manager  
water depth to surface in the well 619-85  
Form C-11/81

Must be filed with the K.C.C. five (5) days prior to commencing well  
 This card void if drilling not started within six (6) months of date received by K.C.C.


RECEIVED  
 STATE CORPORATION COMMISSION  
 6-14-85  
 JUN 14 1985

RECEIVED  
 STATE CORPORATION COMMISSION  
 JUN 19 1985

A Regular Section of Land  
 1 Mile x 5.280 Feet

Important procedures to follow:

1. Notify District office before setting surface casing. *and verify plugging skin. at that time*
2. Set surface casing by circulating cement to the top.
3. File completion forms ACO-1 with K.C.C. within 90 days of well completion, following instructions on ACO-1, side 1, and including copies of wireline logs.
4. Notify District office 48 hours prior to old well workover or re-entry.
5. *When filing intent* Prior to plugging, prepare a plugging plan, then obtain agreement from the appropriate district office for an approved plugging plan.
6. Submit plugging report (CP-4) to K.C.C. after plugging is completed.
7. Obtain an approved injection docket number before disposing of salt water.
8. Notify K.C.C. within 10 days when injection commences or terminates.
9. If an alternate 2 completion, cement in the production pipe from below any usable water to surface within 120 days of spud date.

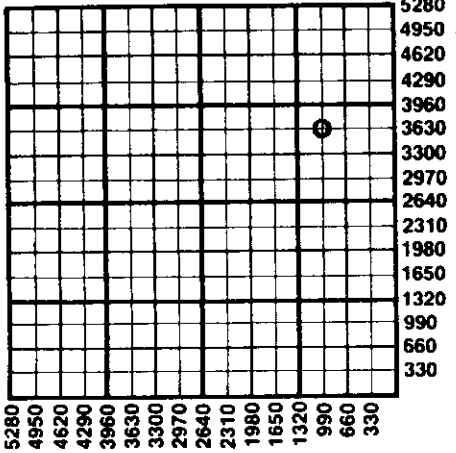

State Corporation Commission of Kansas  
 Conservation Division  
 200 Colorado Derby Building  
 Wichita, Kansas 67202  
 (316) 263-3238