

CARD MUST BE TYPED

State of Kansas
NOTICE OF INTENTION TO DRILL
(see rules on reverse side)

CARD MUST BE SIGNED

Starting Date: December .. 28 .. 85 ..
month day year

OPERATOR: License # 6940.....
Name Dillard L. Brooks.....
Address 1510 Broad Acres.....
City/State/Zip Norman, Oklahoma 73072.....
Contact Person Lee Brooks.....
Phone 405-329-1177.....

CONTRACTOR: License # 5138.....
Name Cougar Drilling Co., Inc.....
City/State Wichita, Kansas.....

Well Drilled For:		Well Class:	Type Equipment:
<input checked="" type="checkbox"/> Oil	<input type="checkbox"/> Swd	<input type="checkbox"/> Infield	<input checked="" type="checkbox"/> Mud Rotary
<input type="checkbox"/> Gas	<input type="checkbox"/> Inj	<input checked="" type="checkbox"/> Pool Ext.	<input type="checkbox"/> Air Rotary
<input type="checkbox"/> OWWO	<input type="checkbox"/> Expl	<input type="checkbox"/> Wildcat	<input type="checkbox"/> Cable

If OWWO: old well info as follows:

Operator
Well Name
Comp Date Old Total Depth
Projected Total Depth 4500..... feet
Projected Formation at TD Mississippi.....
Expected Producing Formations Tor. and Doug. sand

API Number 15- 007-22, 119-000
1150' (E) of WL of NE/4 East
1000' S. of NL Sec 28 Twp 32. S, Rge 11. West
(location)

4280' Ft North from Southeast Corner of Section
1490' Ft West from Southeast Corner of Section
(Note: Locate well on Section Plat on reverse side)

Nearest lease or unit boundary line 1000! north. feet.
County Barber Co., Kansas.....
Lease Name Lukens..... Well# B-2.....
Domestic well within 330 feet: yes no
Municipal well within one mile: yes no

Depth to Bottom of fresh water 100..... feet
Lowest usable water formation 100..... feet
Depth to Bottom of usable water 100..... feet
Surface pipe by Alternate: 1 2
Surface pipe to be set 280'..... feet
Conductor pipe if any required 0'..... feet
Ground surface elevation 1500'..... feet MSL.
This Authorization Expires 6-26-86.....
Approved By [Signature]

I certify that we will comply with K.S.A. 55-101, et seq., plus eventually plugging holes to K.C.C. specifications.

Date 12-26-85 Signature of Operator or Agent

[Signature]
Jerry W. Williamson-agent

Pres. Cougar Drilg. Co., Inc.
Form C-1 4/84

Must be filed with the K.C.C. five (5) days prior to commencing well
This card void if drilling not started within six (6) months of date received by K.C.C.


RECEIVED
STATE CORPORATION COMMISSION

DEC 26 1985

A Regular Section of Land 12-26-85
1 Mile = 5,280 Ft. CONSERVATION DIVISION

Important procedures to follow:

1. Notify District office before setting surface casing.
2. Set surface casing by circulating cement to the top.
3. File completion forms ACO-1 with K.C.C. within 90 days of well completion, following instructions on ACO-1, side 1, and including copies of wireline logs.
4. Notify District office 48 hours prior to old well workover or re-entry.
5. Prior to plugging, prepare a plugging plan, then obtain agreement from the appropriate district office for an approved plugging plan.
6. Submit plugging report (CP-4) to K.C.C. after plugging is completed.
7. Obtain an approved injection docket number before disposing of salt water.
8. Notify K.C.C. within 10 days when injection commences or terminates.
9. If an alternate 2 completion, cement in the production pipe from below any usable water to surface within 120 days of spud date.

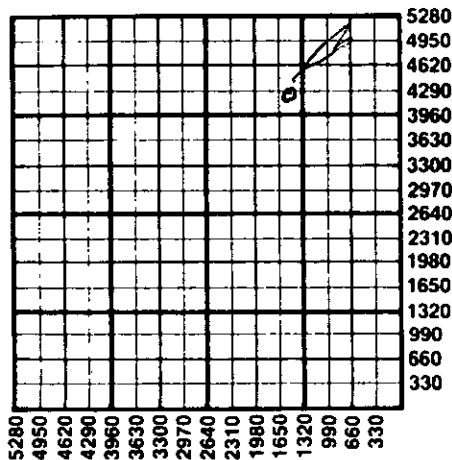

State Corporation Commission of Kansas
Conservation Division
200 Colorado Derby Building
Wichita, Kansas 67202
(316) 263-3238