

CARD MUST BE TYPED

State of Kansas  
**NOTICE OF INTENTION TO DRILL**  
(see rules on reverse side)

CARD MUST BE SIGNED

Starting Date: September 20, 1985  
month day year

API Number 15- 007-23083-0000  
150'N/  
C. NE SE Sec 1 Twp 32S, Rge 11W  East  
(location)  West

OPERATOR: License # 5050  
Name HUMMON CORPORATION  
Address 400 One Main Place  
City/State/Zip Wichita, Kansas 67202  
Contact Person Wilber Berg  
Phone (316) 263-8521

2130 Ft North from Southeast Corner of Section  
660 Ft West from Southeast Corner of Section  
(Note: Locate well on Section Plat on reverse side)

CONTRACTOR: License # 5148  
Name Big-H Drilling, Inc.  
City/State Wichita, Kansas 67202

Nearest lease or unit boundary line 510 feet.  
County Barber  
Lease Name Ketzner Well# 2

Well Drilled For: Well Class: Type Equipment:  
 Oil  Swd  Infield  Mud Rotary  
 Gas  Inj  Pool Ext.  Air Rotary  
 OWWO  Expl  Wildcat  Cable

Domestic well within 330 feet:  yes  no  
Municipal well within one mile:  yes  no  
150

If OWWO: old well info as follows:  
Operator \_\_\_\_\_  
Well Name \_\_\_\_\_  
Comp Date \_\_\_\_\_ Old Total Depth \_\_\_\_\_  
Projected Total Depth 3750 feet  
Projected Formation at TD Lansing  
Expected Producing Formations Douglas Limestone

Depth to Bottom of fresh water \_\_\_\_\_ feet  
Lowest usable water formation Salt Plain Salt  
Depth to Bottom of usable water 200 feet  
Surface pipe by Alternate: 1  2   
Surface pipe to be set 200 feet  
Conductor pipe if any required none feet  
Ground surface elevation \_\_\_\_\_ feet MSI.  
This Authorization Expires 3-12-86  
Approved By 9-12-85

I certify that we will comply with K.S.A. 55-101, et seq., plus eventually plugging hole to K.C.C. specifications.


Date 9/11/85 Signature of Operator or Agent Kenneth S. White Title Agent

*Handwritten signature*  
REARXOHE

Must be filed with the K.C.C. five (5) days prior to commencing well  
This card void if drilling not started within six (6) months of date received by K.C.C.

SEP 12 1985  
9-12-85  
CONSERVATION DIVISION  
Wichita, Kansas

**A Regular Section of Land**  
**1 Mile = 5,280 Ft.**

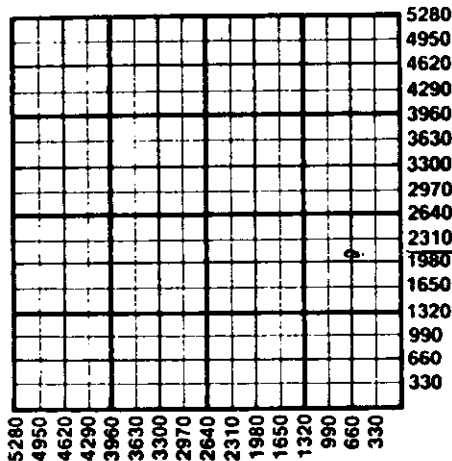

**Important procedures to follow:**

1. Notify District office before setting surface casing.
2. Set surface casing by circulating cement to the top.
3. File completion forms ACO-1 with K.C.C. within 90 days of well completion, following instructions on ACO-1, side 1, and including copies of wireline logs.
4. Notify District office 48 hours prior to old well workover or re-entry.
5. Prior to plugging, prepare a plugging plan, then obtain agreement from the appropriate district office for an approved plugging plan.
6. Submit plugging report (CP-4) to K.C.C. after plugging is completed.
7. Obtain an approved injection docket number before disposing of salt water.
8. Notify K.C.C. within 10 days when injection commences or terminates.
9. If an alternate 2 completion, cement in the production pipe from below any usable water to surface within 120 days of spud date.

State Corporation Commission of Kansas  
Conservation Division  
200 Colorado Derby Building  
Wichita, Kansas 67202  
(316) 263-3238