

CARD MUST BE TYPED

State of Kansas
NOTICE OF INTENTION TO DRILL
(see rules on reverse side)

CARD MUST BE SIGNED

Starting Date: May 27, 1985
month day year 2.13

API Number 15- 007-22048-0000

OPERATOR: License # 5050
Name Hummon Corporation
Address 400 One Main Place
City/State/Zip Wichita, Kansas 67202
Contact Person Wilber Berg
Phone (316) 263.8521

150' W/4 NE, NW Sec. 1 .. Twp. 32. S, Rge 11. .. East
(location) West

... 4620 Ft North from Southeast Corner of Section
... 3450 Ft West from Southeast Corner of Section
(Note: Locate well on Section Plat on reverse side)

CONTRACTOR: License # 5148
Name Big-H Drilling, Inc.
City/State Wichita, Kansas 67202

Nearest lease or unit boundary line 660 feet.
County Barber
Lease Name Chapin Well# 2-1

Well Drilled For: Well Class: Type Equipment:
 Oil Swd Infield Mud Rotary
 Gas Inj Pool Ext. Air Rotary
 OWWO Expl Wildcat Cable

Domestic well within 330 feet : yes no
Municipal well within one mile : yes no

If OWWO: old well info as follows:

Operator
Well Name
Comp Date Old Total Depth
Projected Total Depth 3750 feet
Projected Formation at TD Lansing
Expected Producing Formations Douglas Limestone

Depth to Bottom of fresh water 150 feet
Lowest usable water formation Salt Plain Salt
Depth to Bottom of usable water 200 feet
Surface pipe by Alternate : 1 2
Surface pipe to be set 200 feet
Conductor pipe if any required No feet
Ground surface elevation 1578 feet MSL
This Authorization Expires 11-23-85
Approved By 5-23-85 [Signature]

I certify that we will comply with K.S.A. 55-101, et seq., plus eventually plugging hole to K.C.C. specifications.

Date 5-23-85 Signature of Operator or Agent Kenneth S. White Title
Kenneth S. White,

Agent


MHC/KOHE 5-23-85

RECEIVED
STATE CORPORATION COMMISSION

Must be filed with the K.C.C. five (5) days prior to commencing well
This card void if drilling not started within six (6) months of date received by K.C.C.

5-23-85
MAY 23 1985

CONSERVATION DIVISION
Wichita, Kansas
A Regular Section of Land
1 Mile = 5,280 Ft.

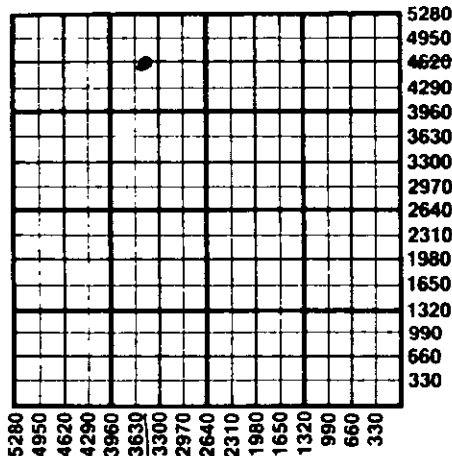

Important procedures to follow :

1. Notify District office before setting surface casing.
2. Set surface casing by circulating cement to the top.
3. File completion forms ACO-1 with K.C.C. within 90 days of well completion, following instructions on ACO-1, side 1, and including copies of wireline logs.
4. Notify District office 48 hours prior to old well workover or re-entry.
5. Prior to plugging, prepare a plugging plan, then obtain agreement from the appropriate district office for an approved plugging plan.
6. Submit plugging report (CP-4) to K.C.C. after plugging is completed.
7. Obtain an approved injection docket number before disposing of salt water.
8. Notify K.C.C. within 10 days when injection commences or terminates.
9. If an alternate 2 completion, cement in the production pipe from below any usable water to surface within 120 days of spud date.

State Corporation Commission of Kansas
Conservation Division
200 Colorado Derby Building
Wichita, Kansas 67202
(316) 263-3238