

CARD MUST BE TYPED

State of Kansas
NOTICE OF INTENTION TO DRILL

CARD MUST BE SIGNED

(see rules on reverse side)

Starting Date:January.....6.....1985.....
month day year

API Number 15- 007-21,981-0000

OPERATOR: License #6006.....120'

S E/2 E/2 NE Sec 15.. Twp 32 S, Rge 11.. East West

NameMolz Oil Company.....

Address R.R. #2, Box 54.....

City/State/Zip Kiowa, Kansas 67070.....

Contact Person Jim Molz.....

Phone 316-296-4558.....

3840..... Ft North from Southeast Corner of Section

330..... Ft West from Southeast Corner of Section

(Note: Locate well on Section Plat on reverse side)

CONTRACTOR: License #5658.....

Name Sweetman Drilling, Inc.....

City/State Wichita, Kansas 67202.....

Nearest lease or unit boundary line330..... feet.

County Barber.....

Lease Name Edith..... Well# 1.....

Domestic well within 330 feet: yes no

Municipal well within one mile: yes no

Well Drilled For: Well Class: Type Equipment:

- Oil Swd Infield Mud Rotary
- Gas Inj Pool Ext. Air Rotary
- OWWO Expl Wildcat Cable

Depth to Bottom of fresh water75..... feet

Lowest usable water formation Permian (salt plain)

Depth to Bottom of usable water 150 200..... feet

Surface pipe by Alternate: 1 2

Surface pipe to be set200'..... feet

Conductor pipe if any required none..... feet

Ground surface elevation1518..... feet MSL

This Authorization Expires 6-19-85

Approved By 12-19-84

If OWWO: old well info as follows:

Operator

Well Name

Comp Date Old Total Depth

Projected Total Depth 4730..... feet

Projected Formation at TD Mississippi.....

Expected Producing Formations

I certify that we will comply with K.S.A. 55-101, et seq., plus eventually plugging hole to K.C.C. specifications.

Date 12-17-84 Signature of Operator or Agent

Title President


Form C-1 4/84

MHC/MOHE 12/19/84

Must be filed with the K.C.C. five (5) days prior to commencing well
 This card void if drilling not started within six (6) months of date received by K.C.C.

Important procedures to follow :

A Regular Section of Land
1 Mile = 5,280 Ft.

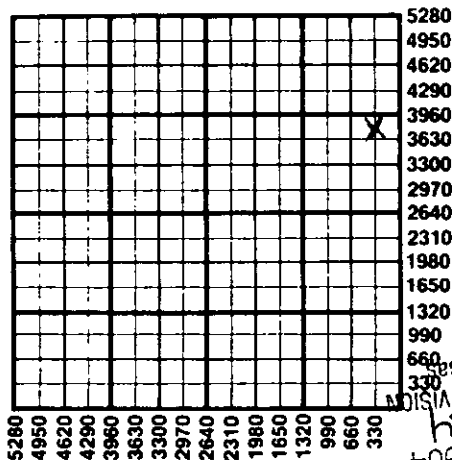

1. Notify District office before setting surface casing.
2. Set surface casing by circulating cement to the top.
3. File completion forms ACO-1 with K.C.C. within 90 days of well completion, following instructions on ACO-1, side 1, and including copies of wireline logs.
4. Notify District office 48 hours prior to old well workover or re-entry.
5. Prior to plugging, prepare a plugging plan, then obtain agreement from the appropriate district office for an approved plugging plan.
6. Submit plugging report (CP-4) to K.C.C. after plugging is completed.
7. Obtain an approved injection docket number before disposing of salt water.
8. Notify K.C.C. within 10 days when injection commences or terminates.

If an alternate 2 completion, cement in the production pipe from below any usable water to surface within 120 days of spud date.

RECEIVED
 STATE CORPORATION COMMISSION
 DEC 19 1984

State Corporation Commission of Kansas
 Conservation Division
 200 Colorado Derby Building
 Wichita, Kansas 67202
 (316) 263-3238