

CARD MUST BE TYPED

State of Kansas
NOTICE OF INTENTION TO DRILL
(see rules on reverse side)

CARD MUST BE SIGNED

Starting Date: .. September .. 9 .. 1985 ..
month day year

API Number 15- 007-22,076-0000
NE SE NW .. Sec .. 14 Twp 30 S, Rge 14 .. East
(location) West

OPERATOR: License # .. 6327 ..
Name .. Kan-Ex, Inc. ..
Address .. 110 S. Main, Suite 800 ..
City/State/Zip .. Wichita, Kansas .. 67202 ..
Contact Person .. Bruce F. Welner ..
Phone .. (316) 267-2585 ..

3630 .. Ft North from Southeast Corner of Section
2970 .. Ft West from Southeast Corner of Section
(Note: Locate well on Section Plat on reverse side)

CONTRACTOR: License # .. 5110 ..
Name .. B. & B. Drilling, Inc. ..
City/State .. Wichita, Kansas .. 67202 ..

Nearest lease or unit boundary line .. 330 .. feet.
County .. Barber ..

Lease Name .. Riepe .. Well# .. 1-14 ..

Well Drilled For: Well Class: Type Equipment:
 Oil Swd Infield Mud Rotary
 Gas Inj Pool Ext. Air Rotary
 OWWO Expl Wildeat Cable

Domestic well within 330 feet : yes no
Municipal well within one mile : yes no

If OWWO: old well info as follows:

Operator ..
Well Name ..
Comp Date .. Old Total Depth ..
Projected Total Depth .. 4900 .. feet
Projected Formation at TD .. Arbuckle ..
Expected Producing Formations .. Mississippi ..

Depth to Bottom of fresh water .. 200.150 .. feet
Lowest usable water formation ..
Depth to Bottom of usable water .. 200 .. feet
Surface pipe by Alternate : 1 2
Surface pipe to be set .. 300 .. feet
Conductor pipe if any required .. None .. feet
Ground surface elevation Appx .. 1920 .. feet MSL.
This Authorization Expires .. 2-29-86 ..
Approved By .. 8-29-85 .. *PC*

I certify that we will comply with K.S.A. 55-101, et seq., plus eventually plugging hole to K.C.C. specifications.


Date .. 8-28-85 .. Signature of Operator or Agent *Bruce F. Welner* Title .. President ..

PC for KONE

Must be filed with the K.C.C. five (5) days prior to commencing well
 This card void if drilling not started within six (6) months of date received by K.C.C.

Important procedures to follow :

**A Regular Section of Land
 1 Mile = 5,280 Ft.**

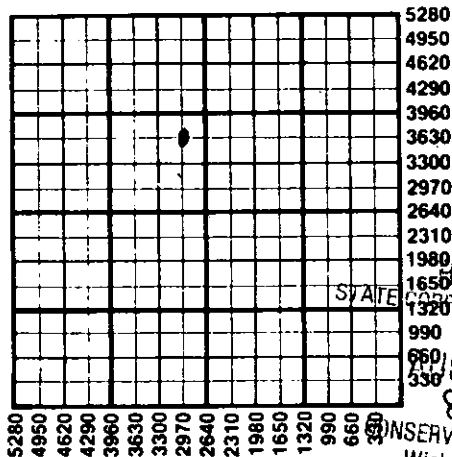

1. Notify District office before setting surface casing.
2. Set surface casing by circulating cement to the top.
3. File completion forms ACO-1 with K.C.C. within 90 days of well completion, following instructions on ACO-1, side 1, and including copies of wireline logs.
4. Notify District office 48 hours prior to old well workover or re-entry.
5. Prior to plugging, prepare a plugging plan, then obtain agreement from the appropriate district office for an approved plugging plan.
6. Submit plugging report (CP-4) to K.C.C. after plugging is completed.
7. Obtain an approved injection docket number before disposing of salt water.
8. Notify K.C.C. within 10 days when injection commences or terminates.
9. If an alternate 2 completion, cement in the production pipe from below any usable water to surface within 120 days of spud date.

RECEIVED
 AUG 29 1985
 8-29-85
 CONSERVATION DIVISION
 Wichita, Kansas

**State Corporation Commission of Kansas
 Conservation Division
 200 Colorado Derby Building
 Wichita, Kansas 67202
 (316) 263-3238**