

8-14-85 2-10-85
CARD MUST BE TYPED

State of Kansas
NOTICE OF INTENTION TO DRILL
(see rules on reverse side)

~~CORRECTED CARD~~
CARD MUST BE SIGNED
8-15-84

Starting Date: 8 22 84
month day year

API Number 15- 077-21,024-00-00

OPERATOR: License # 5087 * 60' S of NE. NE. NW

Sec. 34, Twp. 33, S, Rge. 8... East
 West

Name Texas Energies, Inc.

Address P.O. Box 947

City/State/Zip Pratt, KS 67124

Contact Person Scott Alberg

Phone 316-672-7581

* 4890 Ft North from Southeast Corner of Section

* 2970 Ft West from Southeast Corner of Section
(Note: Locate well on Section Plat on reverse side)

CONTRACTOR: License # 5149

Name Wheatstate Oilfield Services

City/State Pratt, KS 67124

* Nearest lease or unit boundary line 390 feet.

County Harper

Lease Name Morrow Well# 2-34

Domestic well within 330 feet: yes no

Municipal well within one mile: yes no

Well Drilled For: Well Class: Type Equipment:

Oil Swd Infield Mud Rotary

Gas Inj Pool Ext. Air Rotary

OWWO Expl Wildcat Cable

Depth to Bottom of fresh water 200 feet

Lowest usable water formation Harper Siltstone

Depth to Bottom of usable water 200 feet

Surface pipe by Alternate: 1 2

Surface pipe to be set 260 feet

Conductor pipe if any required none feet

Ground surface elevation feet MSL

This Authorization Expires 2-10-85

Approved By 8-10-84

If OWWO: old well info as follows:

Operator

Well Name

Comp Date Old Total Depth

Projected Total Depth 4800 feet

Projected Formation at TD Mississippian

Expected Producing Formations Mississippian

I certify that we will comply with K.S.A. 55-101, et seq., plus eventually plugging hole to K.C.C. specifications. *200 W of NE NE NW*


Date 8-14-84 Signature of Operator or Agent

Scott Alberg

4950 FSL 3170 FEL
Title Operations Geologist

Must be filed with the K.C.C. five (5) days prior to commencing well
This card void if drilling not started within six (6) months of date received by K.C.C.

A Regular Section of Land
1 Mile = 5,280 Ft.

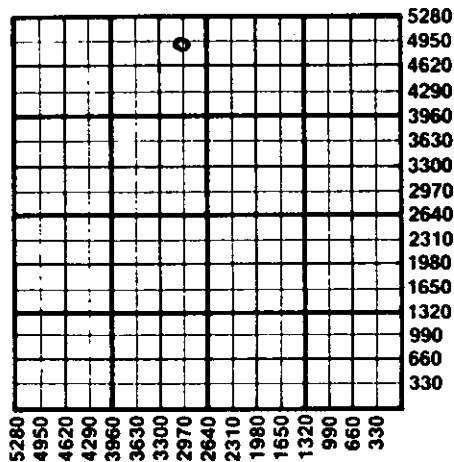

Important procedures to follow

1. Notify District office before setting surface casing.
2. Set surface casing by circulating cement to the top.
3. File completion forms ACO-1 with K.C.C. within 90 days of well completion, following instructions on ACO-1, side 1, and including copies of wireline logs.
4. Notify District office 48 hours prior to old well workover or re-entry.
5. Prior to plugging, prepare a plugging plan, then obtain agreement from the appropriate district office for an approved plugging plan.
6. Submit plugging report (CP-4) to K.C.C. after plugging is completed.
7. Obtain an approved injection docket number before disposing of salt water.
8. Notify K.C.C. within 10 days when injection commences or terminates.
9. If an alternate 2 completion, cement in the production pipe from below any usable water to surface within 120 days of spud date.

RECEIVED
STATE CORPORATION COMMISSION
AUG 15 1984
CONSERVATION DIVISION
Wichita, Kansas

State Corporation Commission of Kansas
Conservation Division
200 Colorado Derby Building
Wichita, Kansas 67202
(316) 263-3238